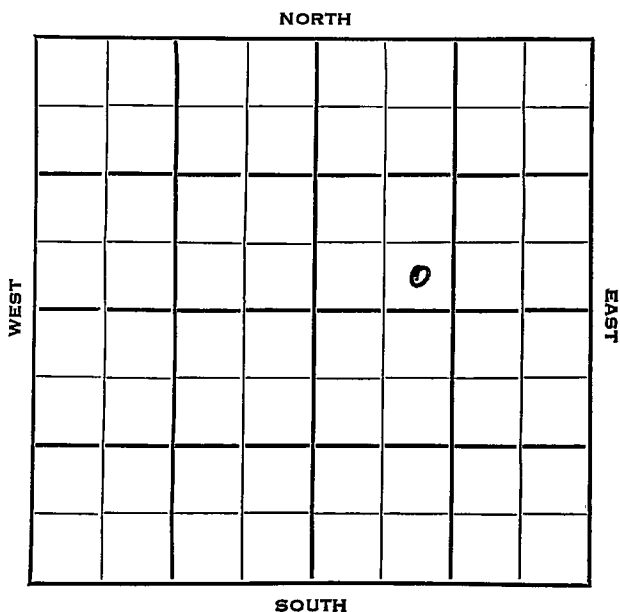


Section 32 Township 18 Range 11 WWell No. # 4 H. SchlochtermeyerCompany Texas Company

Barton

KANSAS

SEC.	TWP.	R.
32	18	11W //

WELL NO.

4 H. Schlochtermeyer FARM

COMPANY

Texas Company

CONTRACTOR

Anschutz


Bieberle Pool

Ft. from N. Line

330 Ft. from S. Line

Ft. from E. Line

990 Ft. from W. Line

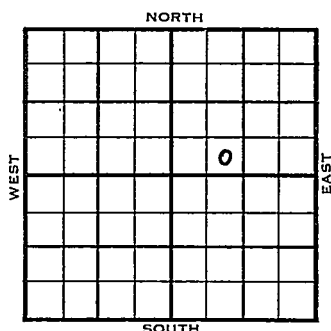

SE SW NE

	ELEVATION	REPORT
1953	1834'	
10/21	Spud 10-16-53 10" @ 647 Drlg. 1675'	
10/28	Heeb 2965', Br li 3077', Lans 3094', Arb. 3408' DST 2902-20', 1 hrs., 1500' gas, 125' g & ocm, 880# Drlg. 3411'	
11/4	TD 3415' 7" @ 3412' CO 3415 FU 636' fluid 2 hrs. S/53 boph, dec. to 34 boph 2 hrs.	
11/11	Spud 10-16-53 Oil Well TD 3415' 10" @ 647' Heeb 2965', Br. Lime 3077', Lans 3094' Arb 3408' DST 2902'-20' opn 1 hr, rec 1500' gas, 125' g & ocm, 880# TD 3415' 7" @ 3412' CO to 3415' FU 635' fluid 2 hr. S/ 53 boph	

1953

Information brought forward.

11/11 dec. to 34 boph 2 hr. .
Comp. 614 bopd.

COMPLETED

J. G. McGEHEE

County Barton State Kansas

Sec. 32 (Blk. Twp.) 18 (Sur. Rge.) 11W Map No.

Operator Texas Company

Well No. 4 Farm H. Schlochtermeyer

Elev.	1834	Location	SE SW NE
-------	------	----------	----------

330 Ft. From S Line NE

990 Ft. From W Line Quarter

1st. Report

Completion NOV 11 1953

Remarks Bieberle Pool

Anschutz Drlg. - Contr.

Spudding Date 10-16-53

Drlg. Data Oil well TD 3415

10" @ 647 Heeb. 2965 Br. lime 3077

Lens. 3094 Arb. 3408. DST 2902-20

open 1 hr. Rec. 1500' gas 125' g & ocm

880# TD 3415 7" @ 3412 CO to 3415

FU 635' fluid 2 hr. S/ 53 boph

dec. to 34 boph 2 hr.

Comp. 614 bopd

J. G. McGEHEE