

O.W.W.O.

Section 14 Township 20 Range 11W


Well No. #7 Landfield (Langfeld)

Company J. O. Williams NCRA.

NORTH

WEST

EAST

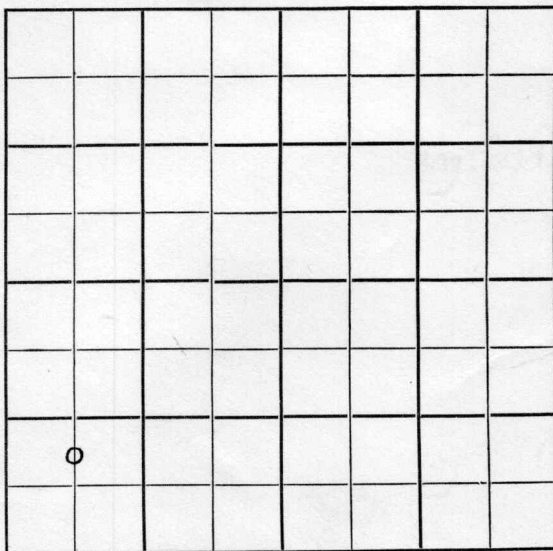

SOUTH

Sec. 14 Twp. 20 R. 11W

Well No. #7 Landfield Farm

J. O. Williams NCR A. Company

Garvey Contractor
Chase


_____ Ft. from N. Line

990 Ft. from S. Line

_____ Ft. from E. Line

660 Ft. from W. Line

N/2 SW SW

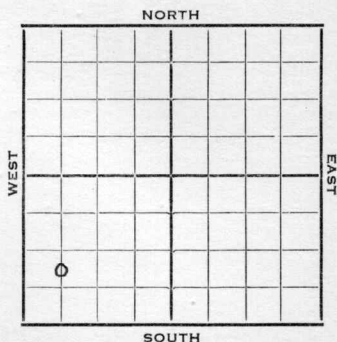

1952 Elev. 1761' REPORT

1/16

Spud 1-11-52

8" @ 288'

Drlg. 2400'

2/6

TD 3281' 5" @ 3280

Testing

2/13

No report

2/20

"

3/5

Spud 1-11-52

Oil well TD 3281' 8" @ 288

Heeb 2876' Br. lime 2997' Lans. 3023

Arb. 3279-81' 5" @ 3280' CO to 3281

FU 800' fluid mostly water. PB 3279'

4/3278-79 water PB 3276' Gamma-ray

KC 3014' Arb. 3275' PB 3277'

250 A S/6 BO 3/4 BW FU 300' oil

1000' water 6 hr.

Comp. 28 BOPD 75% water.

COMPLETED

1955

4/13

O.W.W.O.

Oil Well

TD 3281'

Heeb 2876', Br. Lime 2997', Lans.

3023' Arb. 3279'

OTD 3281'

OVER

1955

Information brought forward.

4/13

5" @ 3280'

CO 3281'

SP 3220

16/ 3177-81 500 A S/ wtr.

PB 3170'

12/ 3158-61 500 A S/ 11.8 bw scum
oil 2 hr. FU 1300' wtr. 12 hr.

SP 3120

16/ 3089-93 S/ 7 bwph 3 hr.

FU 1730' wtr. 12 hr. SP 3070

reset @ 3060 16/ 3043-47 2o gw 36 hr

1000 A S/ 11.3 bw $1\frac{1}{2}$ hr. FU 1050'

wtr. 14 hr.

PB 3000'

35/ 2950-56 1 qt oil 1 hr. 10.2 go

9.18 gw 13 hr petro-frac. S/ 10.14

bo 2 hr. FU 1125' oil 13 hr.

S/ 1.13 boph 4 hr. P/ 15 bo 10 hr.

Comp 30 bopd.


FIRST REPORT
COMPLETED

County Barton State Kansas
 Sec. 14 (Blk.) 20 (Sur.) 11W Map No.

Operator J. O. Williams

Well No. 7 Farm Landfield

Elev. Location N/2 SW SW

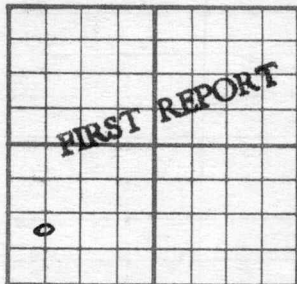

990 Ft. From S Line SW

660 Ft. From W Line Quarter

1st. Report JAN 16 1952

Completion

Remarks

Garvey - Contr.


Spudding Date 1-11-52

Drlg. Data Chase

8" @ 288 Drlg. 2400

J. E. TYRA

County Barton State Kansas
 Sec. 14 (Blk.
Twp.) 20 (Sur.
Rge.) 11W Map No.
 Operator J. O. Williams
 Well No. 7 Farm Landfield
 Elev. 1761 Location C N L SW SW

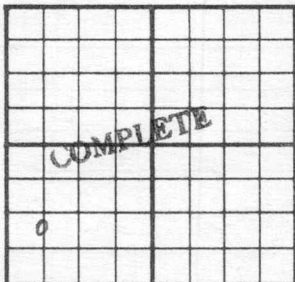

990Ft. From S Line SW
660Ft. From W Line Quarter
 1st. Report
 Completion MAR 5 1952
 Remarks Chase Pool
Garvey - Contr.
 Spudding Date 1-11-52

Drlg. Data Oil well TD 3281

8" @ 288 Heeb. 2876 Br. lime 2997

Lans. 3023 Arb. 3279-81 5" @ 3280

CO to 3281 FU 800' fluid mostly water

PB 3279 4/ 3278-79 water PB 3276

gamma-ray KC 3014 Arb. 3275 PB 3277

250 A S/ 6 bo 3/4 bw FU 300' oil

1000' water 6 hr. Comp. 28 bopd 75% w

J. G. McGEHEE

O.W.W.O.

County Barton State Kansas
 Sec. 14 (Blk.) 20 (Sur.) 11W Map No.
 Operator N C R A (was Williams)
 Well No. 7 Farm Langfeld
 Elev. 1761 Location C N $\frac{1}{2}$ SW SW

990 Ft. From S Line SW
660 Ft. From W Line Quarter
 1st. Report APR 1 3 1955
 Completion APR 1 3 1955
 Remarks O.W.W.O.
 Spudding Date O.W.W.O.

Drlg. Data Oil well TD 3281
Heeb. 2876 Br. lime 2997 Lans 3023
Arb. 3279 OTD 3281 5" @ 3280
CO 3281 SP 3220 16/ 3177-81 500 A
S/ wtr. PB 3170 12/ 3158-61 500 A
S/ 11.8 bw scum oil 2 hr. FU 1300' wtr.
12 hr. SP 3120 16/ 3089-93 S/ 7 bwph
3 hr. FU 1730' wtr. 12 hr. SP 3070
reset @ 3060 16/ 3043-47 20 gw 36 hr.
1000 A S/ 11.3 bw 1 $\frac{1}{2}$ hr. FU 1050' wtr.
14 hr. PB 3000 35/ 2950-56 1 at. oil
1 hr. 10.2 go 9.18 gw 13 hr. petro-frac
S/ 10.14 bo 2 hr. FU 1125' oil 13 hr.
S/ 1.13 boph 4 hr. P/ 15 bo 10 hr.
Comp. 30 bopd

FABEN GILSTRAP