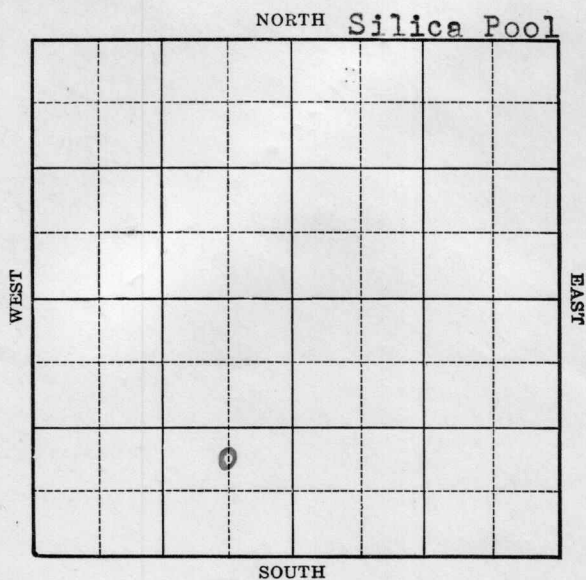


Barton

KANSAS


Section 14 Township 20 Range 11-WWell No. #1 Langfield "B"Company D. R. Buchanan

Sec. 14 Twp. 20 R. 11-WWell No. #1 Langfield "BW" FarmD. R. Buchanan Company

(Silica)

 Ft. from N. Line990 Ft. from S. Line660 Ft. from E. Line Ft. from W. Line

Elev. 1762

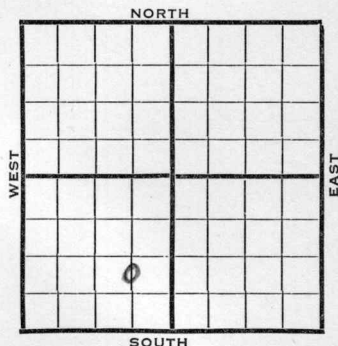

1940	REPORT
7/24	10" - 223' S.O. 3043-40'
	S.O. 3110-16' Drlg. 3280'
8/2	T.D. 3290' 3100' oil.
8/7	Arb. 3278'
	5" - 3279'
	T.D. 3290'
	Depthograph potential 3250 bbls.
	Maximum 3000 bbls.

COMPLETED

Map No. _____ Sec. 14 Twp. 20 R. 11WWell No. 1 Langfield "B"D. R. Buchanan

Company _____

Contractor _____

FIRST REPORT**C N L SE SW**

_____ Ft. from N. Line

990 Ft. from S. Line660 Ft. from E. Line

_____ Ft. from W. Line

SECTION PLAT

	o		

SILICA POOL

Location _____

Rig up _____

Drilling and Remarks:

10" - 223S.O. 3043-40S.O. 3110-16Drlg. 3280**RECORD**

Cased _____ in., _____ ft.

Sand _____

Gas _____

Oil _____

Total Depth _____

PRODUCTION

1st 24 hrs. Nat. _____

1st 24 hrs. after shot _____

Gas _____ Cu. Ft.

Dry Hole _____

Abandoned _____

Date

JUL 24 1940

19

S. J. LEWIS

Scout

Map No. 46 Sec. 14 Twp. 20 R. 11WWell No. 1 Langfield "B"D. R. Buchanan Company

Contractor

COMPLETED

C N L SE SW


_____ Ft. from N. Line

990 Ft. from S. Line660 Ft. from E. Line

_____ Ft. from W. Line

SILICA POOL

SECTION PLAT

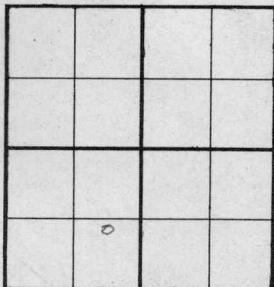

Location _____

Rig up _____

Drilling and Remarks:

*CR 88278**5" @ 8279**Depthograph Plot*
*8250**May 3000*

RECORD

Cased _____ in., _____ ft.

Sand _____

Gas _____

Oil _____

Total Depth 3290

PRODUCTION

1st 24 hrs. Nat. _____

1st 24 hrs. after shot _____

Gas _____ Cu. Ft.

Dry Hole _____

Abandoned _____

Date

AUG 7 1940 19S. J. LEWIS Scout