

Barton

KANSAS

SECTION 32 TOWNSHIP 18 RANGE 11 W

WELL NO. #10 Schlochtermeier

COMPANY Texas Co.

NORTH

				0			

SOUTH

WEST

EAST

Barton

KANSAS

SEC. 32	TWP. 18	R. 11W
------------	------------	-----------

WELL NO.

#10 Schlochtermeyer

FARM

COMPANY

Texas Company

CONTRACTOR

Braden

St. Peter


Ft. from N. Line

Ft. from S. Line

Ft. from E. Line

Ft. from W. Line

NW SW NE

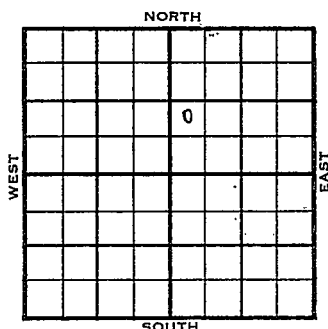

1955	ELEVATION 1841'	REPORT
------	--------------------	--------

12-14 Comm. 12-10-55
10" @ 658/425
Drlg. 1200.

1956

1-11 DST 3148-56 op 1 hr. rec. 50' hocm
50' free oil, 750/30"
7" @ 3420/125
CO to 3435, 5000 A
S/ 42 BO 4 hrs.,
Comp. 406 BOPD
Tp. 2729
H. 2994
BL. 3105
L. 3124 3125
C. 3391
A. ~~3417~~ 3417
TD 3435'

COMPLETED

County Barton Elev. 11W
 Sec. 32- Twp. 18 Rge. 11W
 Company Texas Company
 Farm Name Schlochtermeyer No. 10

TOPS	DEPTH	LOG	DATUM	Loc. in Sec.
Anh.				NW SW NE
Tr.				
Dg.				
Bl.				
L.				
K.C.				Geol.
B.K.C.				Contr.
Ce.				Braden
C.				
M.				Pool
K.				St. Peter
Mz.				
Mo.				
V.				
S.				
S.				
A.				
R.				
Pe.				
G.				
T.D.				

FIRST REPORT

DEC 14 1955

Date Comm. 12-10-55
10" @ 658/425 d rlg. 1200

13

County Barton Elev. 1841
 Sec. 32 Twp. 18 Rgs. 11W
 Company Texas Company
 Farm Name Schlochtermeyer No. 10

TOPS	DEPTH	LOG	DATUM	Loc. in Sec.
Anh.				NW SW NE
Tp.		2729	888	
H.		2994	1153	
Tr.				
Dg.				
BL.		3105	12104	
L.	3124	3125	1284	Geol.
K.C.				
B.K.C.				Contr.
Ce.				Braden
C.		3391	1550	Pool
M.				St. Peter
M.				
K.				
Mz.				
Mq.				
V.				
S.				
S.				
A.		3417	1576	
R.				
Pe.				
G.				
T.D.	3435			

Date Comm. 12-10-55 JAN 1 1 1956

10" @ 658/425 DST 3148-56 open 1 hr.

rec. 50' hocm 50' free oil 750/30"

7" @ 3420/125 C_o to 3435 5000 A

S/ 42 bo 4 hr. Comp. 406 bopd

COMPLETE