

Barton KANSAS

Section 14 Township 20 Range 11-W

Well No. #5 State

Company Derby Oil

NORTH Silica Pool

						0	

WEST

EAST

SOUTH

Sec. 14 Twp. 20 R. 11-W

Well No. #5 State Farm \_\_\_\_\_

Derby Oil Company \_\_\_\_\_


(Silica)

280 Ft. from N. Line

\_\_\_\_\_ Ft. from S. Line

740 Ft. from E. Line

\_\_\_\_\_ Ft. from W. Line

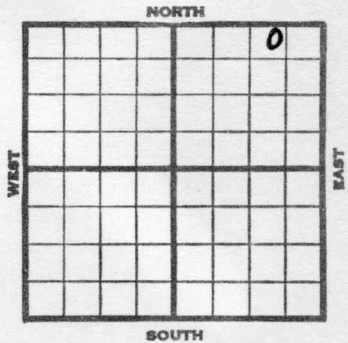

Elev. 1752

1940	REPORT
2/14	Pits.
2/23	Surface hole.
2/29	7" - 258'
	Drlg. 2520'
3/8	Lansing 3026' Arb. 3273-76' TD
	4 1/2" - 3274'
3/14	T.D. 3295' 850' oil 16 hours.
	1000 acid.
3/21	Pump 5 bbls. 6 hours.
3/28	" " " "
4/4	" " " "
4/12	No test.
4/17	Arb. 3273'
	4" - 3274'
	T.D. 3295'
	1000 acid.
	Pump 125 bbls.
	<b>COMPLETED</b>

Map No. 46 Sec. 14 Twp. 20 R. 11W

Well No. 5 State

Derby Oil Company

Contractor

FIRST REPORT

NW NE NE

280 Ft. from N. Line

\_\_\_\_\_ Ft. from S. Line

740 Ft. from E. Line

\_\_\_\_\_ Ft. from W. Line

SILICA POOL

SECTION PLAT

			0

Location \_\_\_\_\_

Rig up \_\_\_\_\_

Drilling and Remarks:  
**Pits**

RECORD

Cased \_\_\_\_\_ in., \_\_\_\_\_ ft.

Sand \_\_\_\_\_

Gas \_\_\_\_\_

Oil \_\_\_\_\_

Total Depth \_\_\_\_\_

PRODUCTION

1st 24 hrs. Nat. \_\_\_\_\_

1st 24 hrs. after shot \_\_\_\_\_

Gas \_\_\_\_\_ Cu. Ft.

Dry Hole \_\_\_\_\_

Abandoned \_\_\_\_\_

Date

FEB 14 1940 19

S. J. LEWIS Scout

Map No. 46 Sec. 14 Twp. 20 R. 11W

Well No. 5 State

Derby Oil

Company

Contractor

COMPLETED

SECTION PLAT

			o

NW NE NE

280 Ft. from N. Line

Ft. from S. Line

740 Ft. from E. Line

Ft. from W. Line

SILICA POOL

Location \_\_\_\_\_

Rig up \_\_\_\_\_

Drilling and Remarks:

*Art 3273*

*4" @ 3274*

*1000 and*

*Pump 125846*

RECORD

Cased \_\_\_\_\_ in., \_\_\_\_\_ ft.

Sand \_\_\_\_\_

Gas \_\_\_\_\_

Oil \_\_\_\_\_

Total Depth 3295.

PRODUCTION

1st 24 hrs. Nat. \_\_\_\_\_

1st 24 hrs. after shot \_\_\_\_\_

Gas \_\_\_\_\_ Cu. Ft.

Dry Hole \_\_\_\_\_

Abandoned \_\_\_\_\_

Date

APR 17 1940

19

S. J. LEWIS

Scout