


Section 14 Township 20 Range 11-W

Well No. #5 Zahorsky

Company Gulf

NORTH **Silica Pool**

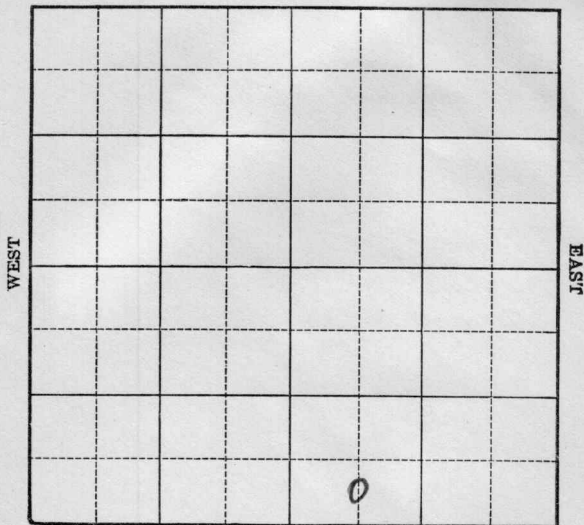

SOUTH

KANSAS

Barton


Sec. 14 Twp. 20 R. 11-WWell No. #5 Zahorsky FarmGulf

Company

(Silica)

 Ft. from N. Line330 Ft. from S. Line Ft. from E. Line660 Ft. from W. Line

Elev. 1758

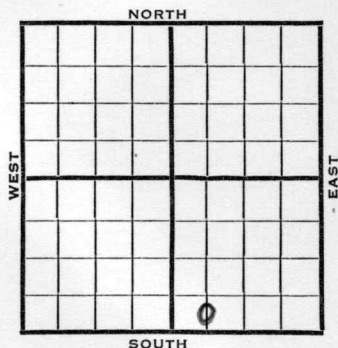

1940	REPORT
5/22	Derrick.
5/29	"
6/6	8" - 182' Drlg. 3048'
6/13	Arb. 3264' 5" - 3268½'
	At 3274' - 3200' oil 4 hours.
6/19	Arb. 3264'
	5" - 3268½'
	T.D. 3274'
	2000 acid.
	Sonimeter potential 16,755 bbls
	Maximum 3000 bbls.
	COMPLETED

Map No. 46 Sec. 14 Twp. 20 R. 11W

Well No. 5 Zahorsky

Gulf Company

Contractor

FIRST REPORT

C S L SW SE

Ft. from N. Line

330 Ft. from S. Line

Ft. from E. Line

660 Ft. from W. Line

Silica Pool

SECTION PLAT

Location

Rig up

Drilling and Remarks:

Derrick

RECORD

Cased _____ in., _____ ft.

Sand _____

Gas _____

Oil _____

Total Depth _____

PRODUCTION

1st 24 hrs. Nat. _____

1st 24 hrs. after shot _____

Gas _____ Cu. Ft.

Dry Hole _____

Abandoned _____

Date

MAY 22 1940

S. J. LEWIS Scout

Map No. 46 Sec. 14 Twp. 20 R. 11WWell No. 5 ZahorskyGulf

Company

Contractor

COMPLETED

C S L SW SE

Ft. from N. Line


330 Ft. from S. Line

Ft. from E. Line

660 Ft. from W. Line

Silica Pool

SECTION PLAT

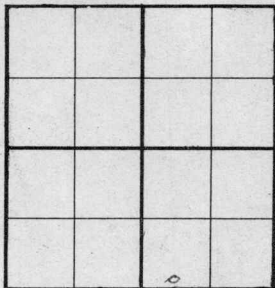

Location

Rig up

Drilling and Remarks:

*Cu 83264**5" @ 3268 1/2**2000 acid**Sonic meter P & X**16755**Max 3000*

RECORD

Cased _____ in., _____ ft.

Sand _____

Gas _____

Oil _____

Total Depth 8274

PRODUCTION

1st 24 hrs. Nat. _____

1st 24 hrs. after shot _____

Gas _____ Cu. Ft.

Dry Hole _____

Abandoned _____

Date

JUN 19 1940 19

S. J. LEWIS

Scout