

KANSAS


Barton County, Kansas
Silica Pool

Form 51—5M—7-39—Palace

Section 14 Township 20 Range 11W

Well No. #6 Zahorsky

Company Gulf

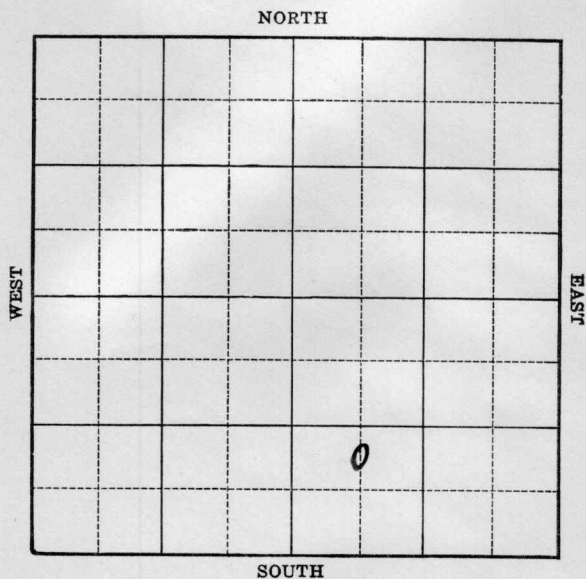

KANSAS

Barton

Sec. 14 Twp. 20 R. 11-W

Well No. #6 Zahorsky Farm _____

Gulf

Company

(Silica)


Ft. from N. Line

990 Ft. from S. Line

Ft. from E. Line

660 Ft. from W. Line

Elev. 1756

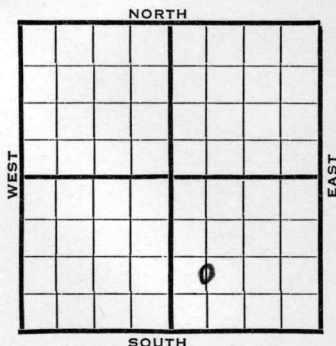[illegible]

Map No. 46 Sec. 14 Twp. 20 R. 11WWell No. 6 Zahorsky
Gulf

Company

Contractor

FIRST REPORT

SECTION PLAT

C N L SW SE

990 Ft. from N. Line660 Ft. from S. Line660 Ft. from E. Line660 Ft. from W. Line

SILICA POOL

		o	

Location

Rig up

Drilling and Remarks:

Drlg. 2410

RECORD

Cased in., ft.Sand Gas Oil Total Depth

PRODUCTION

1st 24 hrs. Nat. 1st 24 hrs. after shot Gas Cu. Ft.Dry Hole Abandoned

Date

JUN 26 1940

19

S. J. LEWIS

Scout

Map No. _____ Sec. 14 Twp. 20 R. 11WWell No. 6 Zahorsky

Gulf

Company

Contractor

COMPLETED

SECTION PLAT

C N L SW SE

_____ Ft. from N. Line

990 Ft. from S. Line

_____ Ft. from E. Line

660 Ft. from W. Line

		o	

SILICA POOL

Location _____

Rig up _____

Drilling and Remarks:

*Cu 83265**5" @ 3265 1/2**Eclometes P.D.**3225**Max 3000*

RECORD

Cased _____ in., _____ ft.

Sand _____

Gas _____

Oil _____

Total Depth 3270

PRODUCTION

1st 24 hrs. Nat. _____

1st 24 hrs. after shot _____

Gas _____ Cu. Ft.

Dry Hole _____

Abandoned _____

Date

JUL 10 1940 19S. J. LEWIS Scout