


KANSAS

Barton

Section 14 Township 20 Range 11WWell No. 8 ZahorskyCompany Gulf

Silica

NORTH

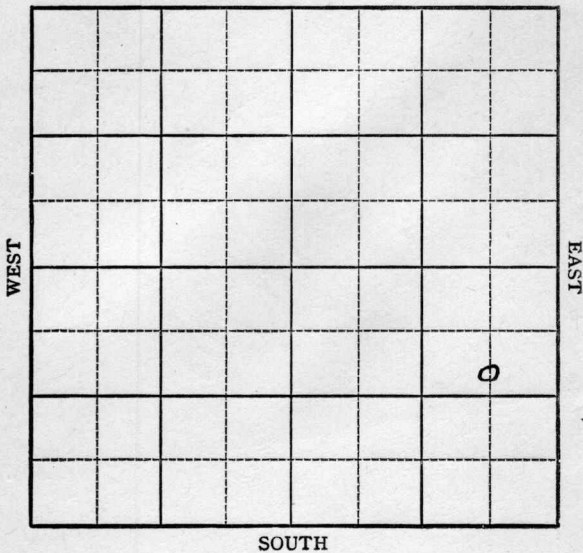


KANSAS

Sec. 14 Twp. 20 R. 11WWell No. #8 Zahorsky FarmGulf Company

Silica Pool

990' Ft. from N. Line Ft. from S. Line660' Ft. from E. Line Ft. from W. Line

C S L NESE

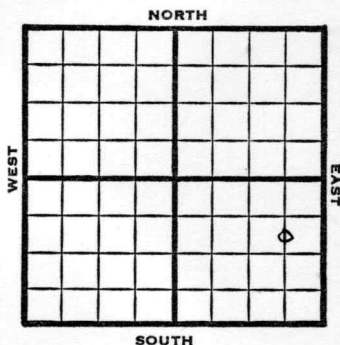

1949

Elev 1756'

REPORT

1/12

Anhy. 458

8" @ 465

Drlg. 2110'

1/19

Arb 3264-66'

TD 3266'

6"@ 3264'

1/26

TD 3274

Swb 81 Bbls oil 5 hrs.

2/2 500 acid swb 137 bbls oil 3 hrs.

2/9

Swb 387 bbls oil 24 hrs

1000 acid

Swb 102 bbls oil 2 hrs.

2/16

"

2/23

TD 3274'

Arb. 3264'

6"@ 3264'

500 acid

Echo Pot 2000 Oil

42° Gr.

Comp

COMPLETED

Map No. _____ Sec. 14 Twp. 20 R. 11W

Well No. 8 Zahorsky

Gulf Company

Contractor

C S L NE SE **FIRST REPORT**


SECTION PLAT

990 Ft. from N. Line

_____ Ft. from S. Line

660 Ft. from E. Line

_____ Ft. from W. Line

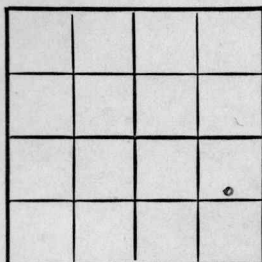

Barton County

RECORD

Location _____

Cased _____ in., _____ ft.

Rig up _____

Sand _____

Drilling and Remarks:

Gas _____

Anhy 458

Oil _____

8" @ 465

Total Depth _____

drlg. 2110

PRODUCTION

1st 24 hrs. Nat. _____

1st 24 hrs. after shot _____

Gas _____ Cu. Ft.

Dry Hole _____

Abandoned _____

Date

JAN 12 1949 19

S. J. LEWIS Scout

Kansas

Map No. K-46 Sec. 14 Twp. 20 R. 11WWell No. 8 Zahorsky

Gulf

Company


COMPLETE

Contractor

C S L N E S E

E11256.

SECTION PLAT

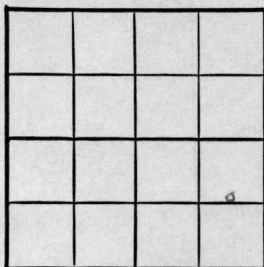990 Ft. from N. Line Ft. from S. Line660 Ft. from E. Line Ft. from W. Line

Barton County

Location Rig up

Drilling and Remarks:


RECORD

Cased in., ft.Sand Gas Oil Total Depth 3274

PRODUCTION

1st 24 hrs. Nat. 1st 24 hrs. after shot Gas Cu. Ft.Dry Hole Abandoned

Date

FEB 23 1949

19

S. J. LEWIS

Scout