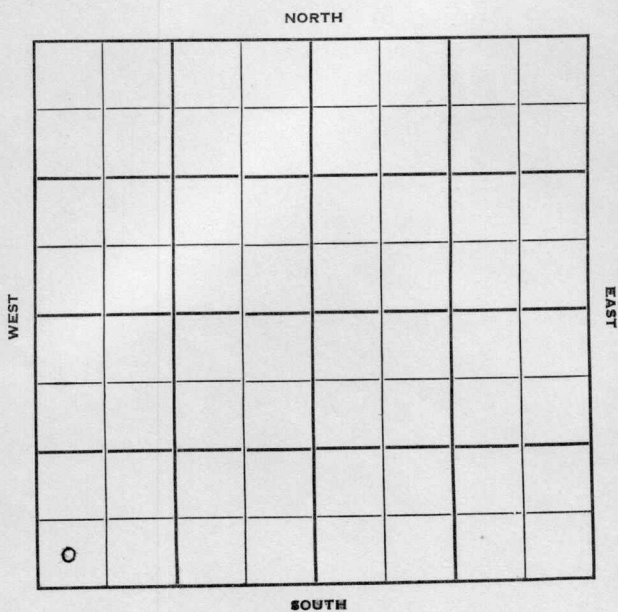


Section 15 Township 20 Range 11WWell No. #2 BrennCompany Henderson et al

KAL

Barton

Sec. 15 Twp. 20 R. 11-W ✓

Well No. #2 Brenn Farm

Henderson etal Company

Todd Drlg. Contractor

Silica


 Ft. from N. Line

330 Ft. from S. Line

 Ft. from E. Line

330 Ft. from W. Line

SW SW SW

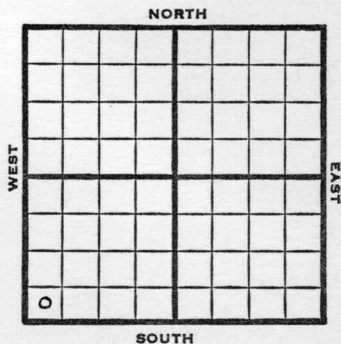

1950 Elev. 1768' REPORT

9/27 Spud 9-23-50
8" @ 324
Anhy 505-30
drlg 1085

10/18 Spud 9-23-50
Oil Well TD 3308'
8" @ 324' Anhy 505-30
Top 2646' Heeb. 2913'
Br Line 3040' Lans. 3058'
Arb. 3303-06'
4 1/2" @ 3304' TD 3308'
750 A S/2 BOPH Comp. 25 BOPD

COMPLETED

County Barton State KansasSec. 15 (Blk. 20 (Sur. 11W Map No. 11W)
(Twps.) (Rge.)Operator Henderson etal.Well No. 2 Farm BrennElev. _____ Location SW SW SW

0							

330 Ft. From S Line SW330 Ft. From W Line Quarter1st. Report SEP. 27 1950

Completion _____

Remarks _____

Todd D.,lg. - ContractorSpudding Date 9-23-50Drlg. Data Silica Pool8" @ 324 Anhy 505-30 drlg. 1085

J. E. TYRA

County Barton State KansasSec. 15 (Blk. Twp.) 20 (Sur. Rge.) 11W Map No.Operator Henderson et al.Well No. 2 Farm BrennElev. 1768 Location SW SW SW330 Ft. From S Line SW330 Ft. From W Line Quarter1st. ReportCompletion OCT 18 1950Remarks Silica PoolTodd Drlg. - Contr.Spudding Date 9-23-50Drlg. Data Oil well TD 33088" @ 324 Anhy 505-30 Top. 2646Heeb. 2913 Br. line 3040 Lans. 3058Arb. 3303-06 4½" @ 3304 TD 3308750 A S/ 2 boph Comp. 25 bopd

J. E. TYRA