
FORM 51 25M 3-49 PETROL

Rice KANSAS

Section 28 Township 18 Range 9 W

Well No. # 1 Maxwell

Company Lindsley Drlg.

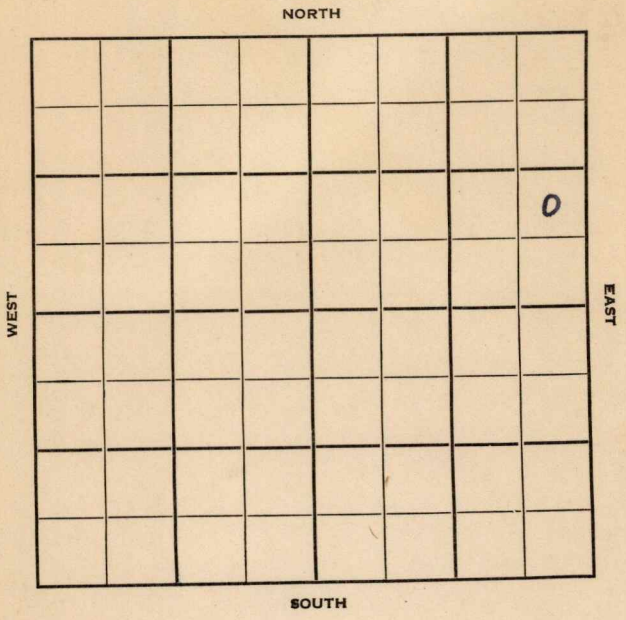

FORM 252-B
10M 8-51 TPCO.

KANSAS ✓

Rice

Sec. 28 Twp. 18 R. 9W

Well No. #1 Maxwell Farm

Lindsley Drlg. Company

Lindsley Contractor


Ft. from N. Line

990 Ft. from S. Line

330 Ft. from E. Line

Ft. from W. Line

NE SE NE

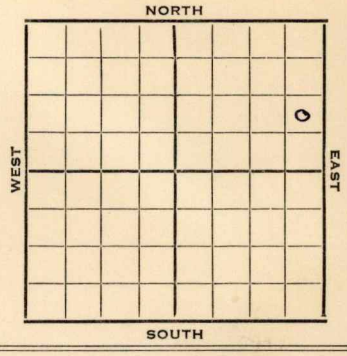

1952	Elev. 1718' REPORT
5/21	RU
5/28	8" @ 260' Drlg. 3130'
6/11	Spud 5-19-52 D&A TD 3276 8" @ 260 Heeb. 2732 Lans. 2819 BKC 3164 Cong. 3244 Arb. 3257-76 TD D&A ABANDONED

FORM 275 FOR SALE BY KANSAS BLUE PRINT CO.


County Rice State Kansas

Sec. 28 (Blk. Twp.) 18 (Sur. Rge.) 9W Map No.

Operator Lindsley Drlg.

Well No. 1 Farm Maxwell

Elev. Location NE SE NE

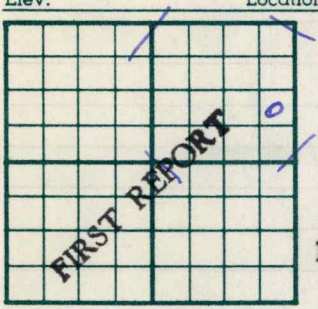

990 Ft. From S Line NE

330 Ft. From E Line Quarter

1st. Report MAY 21 1952

Completion

Remarks

Lindsley - Contr.

Spudding Date

Drlg. Data

RU

J. G. McGEHEE

FORM 275 FOR SALE BY KANSAS BLUE PRINT CO


County Rice State Kansas

Sec. 28 (Blk. Twp.) 18 (Sur. Rge.) 9W Map No.

Operator Lindsley Drlg.

Well No. 1 Farm Maxwell

Elev. 1718 Location NE SE NE

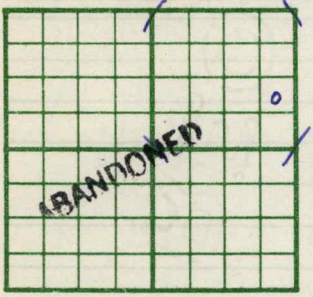

990 Ft. From S Line NE

330 Ft. From E Line Quarter

1st. Report

Completion JUN 11 1952

Remarks

Lindsley - Contr.

Spudding Date 5-19-52

Drlg. Data D & A TD 3276

8" @ 260 Heeb. 2732 Lans. 2819

B KC 3164 Cong. 3244 Arb. 3257-76 TD

D & A

J. G. McGEHEE