

KANSAS

Barton


Form 51-5M-7-39-Palace

Section 15 Township 20 Range 11-W

Well No. #6 Etta Jutting

Company Stanolind

NORTH Silica Pool

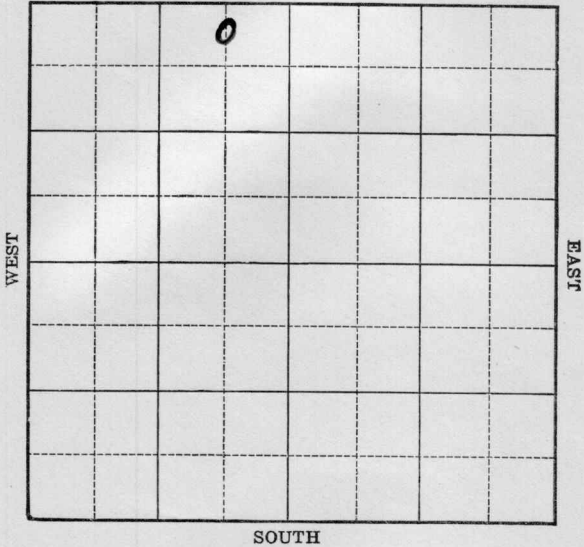

Sec. 15 Twp. 20 R. 11-W

Well No. #6 Etta Jutting Farm
Stanolind Company

(Silica)


390 Ft. from N. Line

_____ Ft. from S. Line

660 Ft. from E. Line

_____ Ft. from W. Line

Elev. 1769

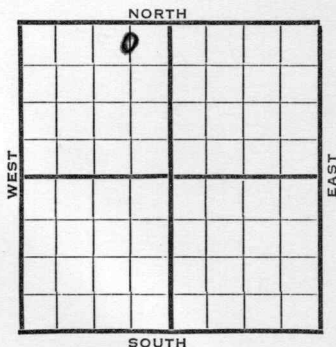

1940	REPORT
3/27	Location
4/4	Drlg. 100'
4/12	Anhy 495' Drlg. 2705'
4/18	Arb. 3299-3303' T.D. 5" - 3299'
	RUST.
4/25	T.D. 3310' 900 acid.
	Swab 1½ bbls. per hour.
	10 qts. at 3304-10' C.O.
5/2	P.B. 3302½' Drlg. cement.
5/9	T.D. 3312' 1000 acid. No help.
5/16	" " " " "
5/22	Arb. 3299'
	5" - 3299'
	T.D. 3312'
	Shot 10 qts. 3304-10'
	1900 acid.
	Potential 342 bbls., pump.
	COMPLETED

Map No. 46 Sec. 15 Twp. 20 R. 11W

Well No. 6 Etta Jutting

Stanolind

Company

Contractor

FIRST REPORT

SECTION PLAT

C N L NE NW

390 Ft. from N. Line

_____ Ft. from S. Line

660 Ft. from E. Line

_____ Ft. from W. Line

SILICA POOL

	e		

Location X

Rig up _____

Drilling and Remarks:

RECORD

Cased _____ in., _____ ft.

Sand _____

Gas _____

Oil _____

Total Depth _____

PRODUCTION

1st 24 hrs. Nat. _____

1st 24 hrs. after shot _____

Gas _____ Cu. Ft.

Dry Hole _____

Abandoned _____

Date

MAR 27 1940₁₉

S. J. LEWIS

Scout

Map No. 46 Sec. 15 Twp. 20 R. 11W

Well No. 6 Etta Jutting

Stanolind Company

Contractor

COMPLETED

SECTION PLAT

C N L NE NW
390 Ft. from N. Line
 _____ Ft. from S. Line
660 Ft. from E. Line
 _____ Ft. from W. Line

SILICA POOL

Location _____

Rig up _____

Drilling and Remarks:

cu & 3299
5" @ 3289
Shut 109 to 330410
1900 acid
Pump 342 P.D.

RECORD

Cased _____ in., _____ ft.
 Sand _____
 Gas _____
 Oil _____
 Total Depth 3312

PRODUCTION

1st 24 hrs. Nat. _____
 1st 24 hrs. after shot _____
 Gas _____ Cu. Ft.
 Dry Hole _____
 Abandoned _____

Date

MAY 22 1940

19

S. J. LEWIS Scout