


DX 78-1 Rice

Section 29 Township 18 Range 9W

Well No. #2 Haxton

Company Lewis Drlg et al

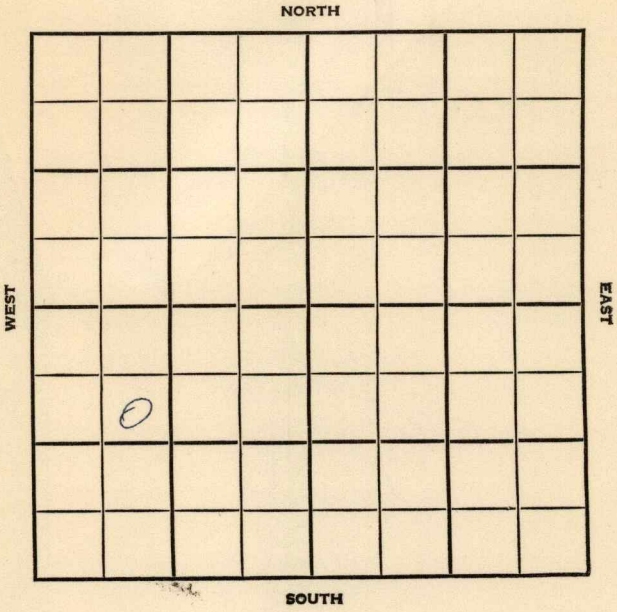

Ride

KANSAS

SEC.

TWP.

R.

29

18

9W

WELL NO.

#2 Haxton

FARM

COMPANY

Lewis Drlg.,etal

CONTRACTOR

Col Tools


_____ FT. FROM N. LINE

_____ FT. FROM S. LINE

_____ FT. FROM E. LINE

_____ FT. FROM W. LINE

SE NW SW

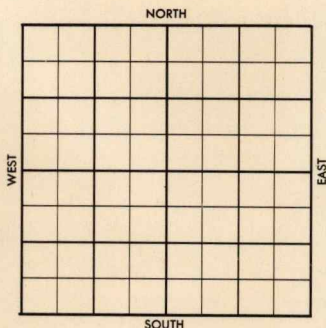

1956

ELEVATION

1722'

REPORT

5-29

Comm. 5-18-56

8" @ 200 w/150

DST 2953-61 op 1 hr. rec. 15' mud, 0#.

DST 3238-46 op 1 hr. rec. 15' mud, 980#

DST 3243-51 op 1 hr. rec. 20' ocm, 860#

DST ~~##~~ 3260-68 op 1 hr. rec. 1500' sw,

5" @ 3285 w/75

WOC

TD 3285'

6-13

45' ocm

BHP 1010

WOCT

DST 3250-60 60 min. rec. 45' OCM

BHP 1010

Pt 8/3260-62 550

500A & watr.

Sq. pfs

plug 3258

pf 32/3245-53

Bal. 10 goph NW. 500A

8 1/2 boph / 1/2 bwph.

D & A

H. 2751', B.L. 2880', L. 2903',

Eros 3232', Solid 3238',

TD 3285'

ABANDONED

County Rice Elev. 1722
 Sec. 29 Twp. 18 Rge. 9W
 Company Lewis Drlg. etal.
 Farm Name Haxton No. 2

Co.

Lse.

No.

Sec.

T.

R.

TOPS	DEPTH	LOG	DATUM
Anh.			
Tp.			
H.			
Tr.			
Dg.			
B.L.			
L.			
K.C.			
B.K.C.			
Ce.			
C.			
M.			
M.			
K.			
Mz.			
Mq.			
V.			
S.			
S.			
A.			
R.			
Pf.			
G.			
T.D.			

Loc. in Sec.

SE NW SW

Geol.

Contr.

Co. tools

Pool

FIRST REPORT

MAY 29 '56

Date Comm. 5-18-56

8" @ 200/150 DST 2953-61 open 1 hr.

rec. 15' mud 0# DST 3238-46

open 1 hr. rec. 15' mud 980#

DST 3243-51 open 1 hr. rec. 20' ocm

860# DST 3260-68 open 1 hr. rec.

1500' SW TD 3285 5" @ 3285/75 WOC

.D.R.

County Rice Elev. 1722
 Sec. 29 Twp. 18 Rgs. 9W
 Company Lewis Drile, etal.
 Farm Name Haxton No. 2

TOPS	DEPTH	LOG	DATUM	Loc. in Sec.
Anh.				
TP.				SE NW SW
H.	<u>2751</u>			
Tr.				
Dg.				
BL.	<u>2840</u>			
L.	<u>2903</u>			
K.C.				Geol.
B.K.C.				Contr.
Ce.				Co. tools
C.				
M.				Pool
M.				
K.				
Mz.				
Mq.				
V.				
S.				
S.				
A. <u>eros</u>	<u>3232</u>			
R. <u>Solid</u>	<u>3238</u>			ABANDONED
Pe.				
G.				
TD	<u>3285</u>			

Date Comm. 5-18-56

8" @ 200/150 DST 2953-61 open 1 hr.

rec. 15' mud 0# DST 3238-46

open 1 hr. rec. 15' mud 980#

DST 3253-51 open 1 hr. rec. 20' ocm

860# DST 3260-68 open 1 hr. rec. 150#

~~1500#~~ TD 3285 5" @ 3285/75 WOCJUN 6 '56 45' OCM BHP 1010

WOC. JUN 13 '56

DST 3250-60 (60) rec

45' OCM BHP 1010

29-18-9W

SE NW SW

pt 8/3260-62 550
 500 A 8 wt- 50 pfs

plug 3258 pt 32/3245-53

Del 10 goph NW 500 A 8 1/2

PH + 1/2 BWPH

D. J.