

Barton



Sec. 15 **KANSAS** Twp. 20 R. 11W

Well No. #1 Jutting Farm

R.L. Williams Company


Silica
Ft. from N. Line

660
Ft. from S. Line

Ft. from E. Line

330
Ft. from W. Line

C W L SW NE

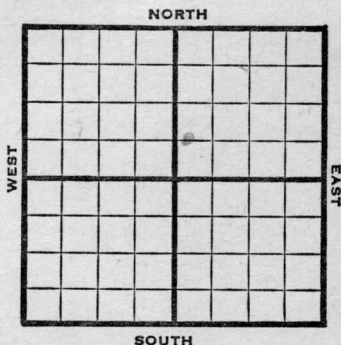

1947 Elev. 1765' REPORT

9/10 8" @ 160
anhy 503
drlg. 2800

9/17 Lans. 3066'
Cong. 3315'
Arbuckle 3323'
Total 3343'

ABANDONED

Map No. _____ Sec. 15 Twp. 20 R. 11W

Well No. 1 Jutting


R. L. Williams Company

FIRST REPORT

Contractor

C W L SW NE

SECTION PLAT

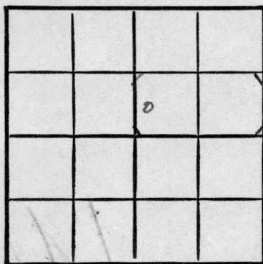

_____ Ft. from N. Line

660 Ft. from S. Line

_____ Ft. from E. Line

330 Ft. from W. Line

Barton County

RECORD

Location _____

Cased _____ in., _____ ft.

Rig up _____

Sand _____

Drilling and Remarks:

Gas _____

8" @ 160

Oil _____

snhy 503

Total Depth _____

drlg. 2800

PRODUCTION

1st 24 hrs. Nat. _____

1st 24 hrs. after shot _____

Gas _____ Cu. Ft.

Dry Hole _____

Abandoned _____

Date

SEP 10 1947 19

S. J. LEWIS

Scout

Map No. 46 Sec. 15 Twp. 20 R. 11W

Well No. 1 Jutting

R. L. Williams Company

ABANDONED Contractor

C W L SW NE


E 1, 1765
SECTION PLAT

 Ft. from N. Line

660 Ft. from S. Line

 Ft. from E. Line

330 Ft. from W. Line

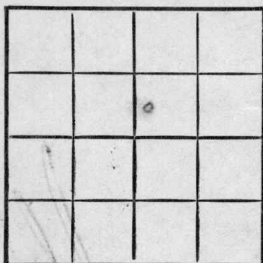

Barton County

Location

Rig up

Drilling and Remarks:

Lane 3066
Cong 3815
Co 4 3823

RECORD

Cased in., ft.

Sand

Gas

Oil

Total Depth 3843

PRODUCTION

1st 24 hrs. Nat.

1st 24 hrs. after shot

Gas Cu. Ft.

Dry Hole

Abandoned

Date

SFP 1 7 1947 19

S. J. LEWIS Scout