FORM 51 10M 2-49 PETROL

KANSAS


Rice

Section 28 Township 18 Range 9W

Well No. 1 Hafferman

Company Appleman et al

Wildcat

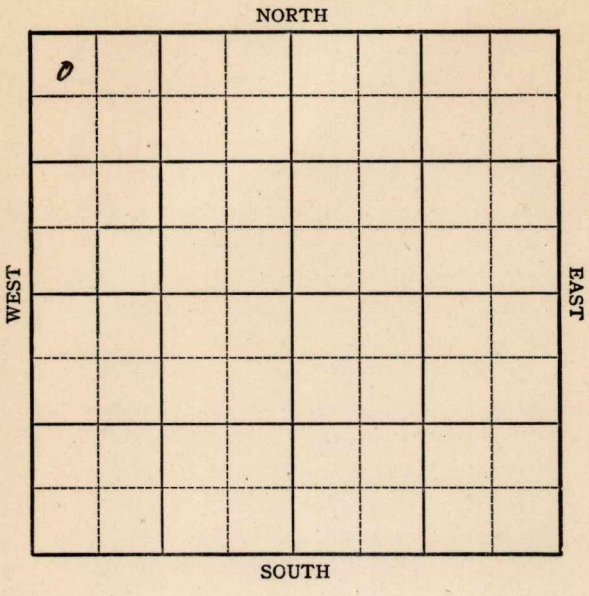

FORM 252-A
5M 10-48 PETROL

KANSAS Rice

Sec. 28 Twp. 18 R. 9W ✓

Well No. #1 Hafferman Farm

Appleman et al Company

Wildcat


330' Ft. from N. Line

Ft. from S. Line

Ft. from E. Line

330' Ft. from W. Line

NW/C

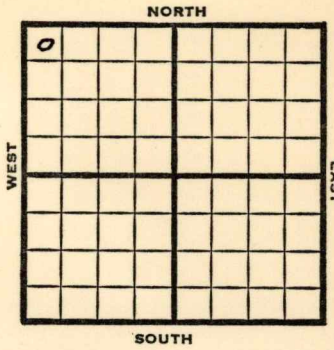

1949	Elev.1714' REPORT
5/18	RUR
5/25	8"@ 188'
	Drlg 2450'
6/1	Lans 2864'
	Arb. 3220-27
	TD 3227'
	5"@ 3220'
6/7	"
6/15	"
6/21	"
6/28	"
7/6	"
7/12	"
7/20	Abandoned.
	Arb. 3220'
	TD 3247'
	ABANDONED

Form 26 200 Bks. 9-48 Petrol

Kansas

Wildcat

Map No. _____ Sec. 28 Twp. 18 R. 9W

Well No. 1 Hafferman


Appleman etal. Company

Contractor

NW/C

FIRST REPORT

SECTION PLAT

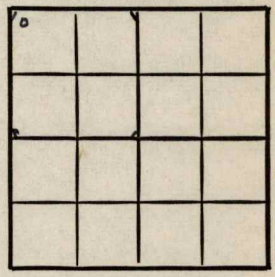

330 Ft. from N. Line

_____ Ft. from S. Line

_____ Ft. from E. Line

330 Ft. from W. Line

Rice County

Location _____

Rig up _____

Drilling and Remarks:

R U R

RECORD

Cased _____ in., _____ ft.

Sand _____

Gas _____

Oil _____

Total Depth _____

PRODUCTION

1st 24 hrs. Nat. _____

1st 24 hrs. after shot _____

Gas _____ Cu. Ft.

Dry Hole _____

Abandoned _____

Date

MAY 18 1949 19

S. J. LEWIS Scout

Form 26 200 Bks. 6-49 Petrol

Kansas Widlcat

Map No. K45 Sec. 28 Twp. 18 R. 9W


Well No. 1 Hafferman

Appleman etal. Company

ABANDONED Contractor

NW/C El. 1714

SECTION PLAT

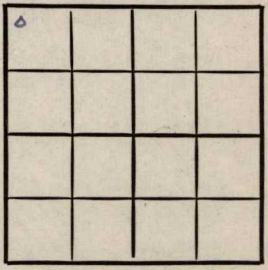

330 Ft. from N. Line

Ft. from S. Line

Ft. from E. Line

330 Ft. from W. Line

Rice County

Location

Rig up

Drilling and Remarks:

Ar +3220

RECORD

Cased in., ft.

Sand

Gas

Oil

Total Depth 3247

PRODUCTION

1st 24 hrs. Nat.

1st 24 hrs. after shot

Gas Cu. Ft.

Dry Hole

Abandoned

Date

JUL 20 1949 19 S. J. LEWIS Scout