

KANSAS

Barton


FORM 51 5M 10-41 PETROL

Section 15 Township 20 Range 11-W

Well No. #1 Langfeld

Company Gulf

Silica Pool

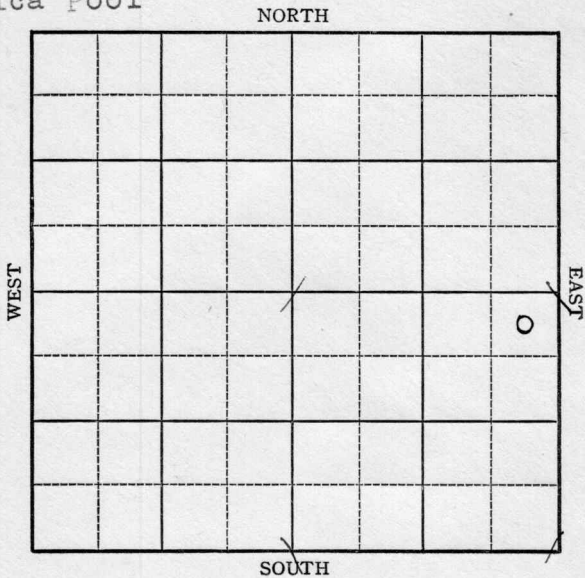

KANSAS

Barton

Sec. 15 Twp. 20 R. 11-WWell No. #1 Langfield FarmGulf Company

Silica Pool


330 Ft. from N. Line

Ft. from S. Line

330

Ft. from E. Line

Ft. from W. Line

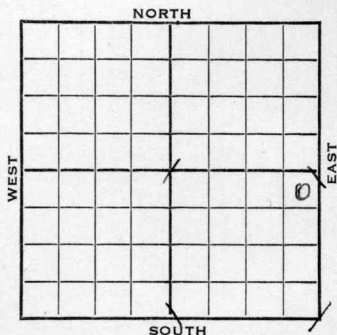NE SE Elev. 1762

1942

REPORT

12/9

10" * 226'

Waiting on cement

12/16

Drlg. 2175

12/22

Lans 3045

SSO 3069-71

Drlg. 3270'

12/29

Arb. 3298-3301 TD

7" - 3299 $\frac{1}{2}$ RUST

1943

1/6

T. D. 3311

2000 gals acid pump 3/4 ft

6 bbls oil 1/4 hrs pump off.

1/13

Arb. 3298

7" casing set 3299 $\frac{1}{2}$ '

T.D. 3311'

Water.

ABANDONED

Barton

KANSAS

Map No. 46 Sec. 15 Twp. 20 R. 11WWell No. 1 Langfeld

Gulf

Company

FIRST REPORT

Contractor

NE SE

SECTION PLAT

330


Ft. from N. Line

Ft. from S. Line

330

Ft. from E. Line

Ft. from W. Line

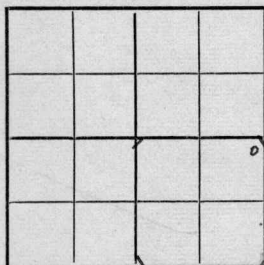

SILICA POOL

Location

Rig up

Drilling and Remarks:

10"-226'

Waiting on
cement

RECORD

Cased _____ in., _____ ft.

Sand _____

Gas _____

Oil _____

Total Depth _____

PRODUCTION

1st 24 hrs. Nat. _____

1st 24 hrs. after shot _____

Gas _____ Cu. Ft.

Dry Hole _____

Abandoned _____

Date

DEC 9

1942

19

S. J. LEWIS

Scout

KANSAS

Barton

Map No. 46 Sec. 15 Twp. 20 R. 11WWell No. 1 Langfeld

Gulf

Company

ABANDONED

Contractor

NE SE

330

Ft. from N. Line


Ft. from S. Line

330

Ft. from E. Line

Ft. from W. Line

SECTION PLAT

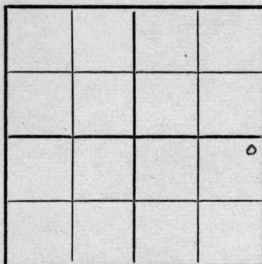

SILICA POOL

Location _____

Rig up _____

Drilling and Remarks:

CR 8298.
2" @ 8299 1/2
2000 Acid
Water.

RECORD

Cased _____ in., _____ ft.

Sand _____

Gas _____

Oil _____

Total Depth 3311

PRODUCTION

1st 24 hrs. Nat. _____

1st 24 hrs. after shot _____

Gas _____ Cu. Ft.

Dry Hole _____

Abandoned _____

Date

JAN 13 1943

19

S. J. LEWIS

Scout