

# KANSAS

Form 51-5M-7-40-Palace


Barton

Section 17 Township 20 Range 11-W

Well No. #2 Clawson

Company Virginia Drilling

NORTH Clawson Pool

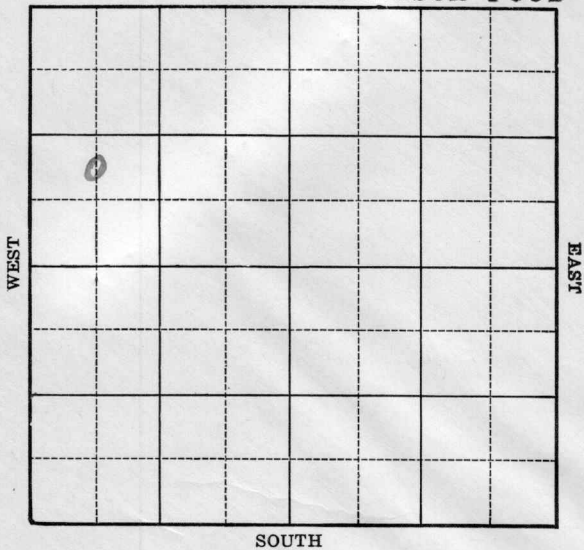



1940  
12/18

Arb. 3290'

7" - 3289'

T.D. 3302'

1000 aci d.

Depthograph potential 3167 bbls.

Maximum 3000 bbls.

40.4 Gravity

COMPLETED

Barton

Map No. 46 Sec. 17 Twp. 20 R. 11WWell No. 2 ClawsonVirginia Drilling

Company

Contractor

## FIRST REPORT

## SECTION PLAT

C N L SW NW


\_\_\_\_\_ Ft. from N. Line

990 Ft. from S. Line

\_\_\_\_\_ Ft. from E. Line

660 Ft. from W. Line

CLAWSON POOL

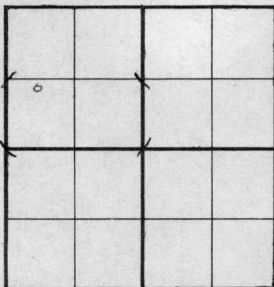Location X

Rig up \_\_\_\_\_

Drilling and Remarks:

## RECORD

Cased \_\_\_\_\_ in., \_\_\_\_\_ ft.

Sand \_\_\_\_\_

Gas \_\_\_\_\_

Oil \_\_\_\_\_

Total Depth \_\_\_\_\_

## PRODUCTION

1st 24 hrs. Nat. \_\_\_\_\_

1st 24 hrs. after shot \_\_\_\_\_

Gas \_\_\_\_\_ Cu. Ft.

Dry Hole \_\_\_\_\_

Abandoned \_\_\_\_\_

Date

SEP 4 1940 19S. J. LEWIS Scout

Map No. 46 Sec. 17 Twp. 20 R. 11W

Well No. 2 Clawson

Virginia Drilling Company

Contractor

**COMPLETED**

C N I SW NW

**SECTION PLAT**

•			

\_\_\_\_\_ Ft. from N. Line

990 Ft. from S. Line

\_\_\_\_\_ Ft. from E. Line

660 Ft. from W. Line

CLAWSON POOL

Location \_\_\_\_\_

Rig up \_\_\_\_\_

Drilling and Remarks:

*Cu #3290*

*7" @ 3289*

*1000 acid*

*Depth P # 3167*

*Max 3000*

*40 # Gr.*

**RECORD**

Cased \_\_\_\_\_ in., \_\_\_\_\_ ft.

Sand \_\_\_\_\_

Gas \_\_\_\_\_

Oil \_\_\_\_\_

Total Depth 3302

**PRODUCTION**

1st 24 hrs. Nat. \_\_\_\_\_

1st 24 hrs. after shot \_\_\_\_\_

Gas \_\_\_\_\_ Cu. Ft.

Dry Hole \_\_\_\_\_

Abandoned \_\_\_\_\_

Date

DEC 18 1940 19

S. J. LEWIS Scout