


Section 17 Township 20 Range 11-WWell No. #3 ClawsonCompany Virginia Drlg.

NORTH Clawson Pool

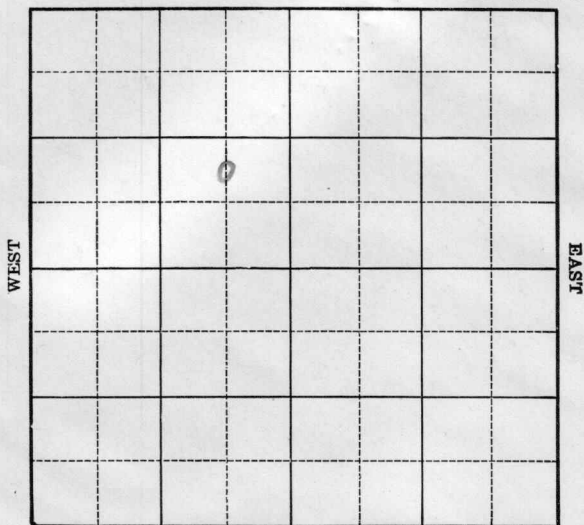


SOUTH

Sec. 17 Twp. 20 R. 11-WWell No. #3 Clawson FarmVirginia Drlg. Company

(Clawson)

 Ft. from N. Line990 Ft. from S. Line660 Ft. from E. Line Ft. from W. Line

Elev. 1778

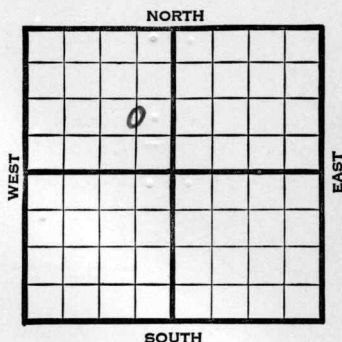

1940	REPORT
11/26	Location
12/5	"
12/12	"
12/19	Derrick.
12/26	"
1941	
1/2	"
1/9	"
1/16	8" - 284' Anhy 530'
	Drlg. 1500'
1/23	Drlg. 2600'
1/30	Arb. ~~3292~~ ³²⁸⁷ 95' T.D. Run pipe.
2/6	Arb. 3287' (Corrected)
	T.D. 3290' 5" - 3288' RUST.
2/13	" " " "
2/20	" " " "
2/27	" " " "
3/6	" " " "
3/13	" " " "
3/20	" " " "
	OVER

1941

3/27

T.D. 3295'

Swab 50 bbls. per hour.

4/2

T.D. 3318' 5000 acid.

4/9

Arb. 3287'

5" - 3288'

T.D. 3318'

5000 acid.

Potential 288 bbls., pump.

40.3 Gravity

COMPLETED

Map No. 46 Sec. 17 Twp. 20 R. 11WWell No. 3 ClawsonVirginia Drlg.

Company _____

FIRST REPORT

Contractor _____

C N L SE NW

SECTION PLAT

	o		

_____ Ft. from N. Line

990 Ft. from S. Line660 Ft. from E. Line

_____ Ft. from W. Line

CLAWSON POOL

Location X

Rig up _____

Drilling and Remarks: _____

RECORD

Cased _____ in., _____ ft.

Sand _____

Gas _____

Oil _____

Total Depth _____

PRODUCTION

1st 24 hrs. Nat. _____

1st 24 hrs. after shot _____

Gas _____ Cu. Ft.

Dry Hole _____

Abandoned _____

Date

NOV 26 1940

19

S. J. LEWIS Scout

Map No. 46 Sec. 17 Twp. 20 R. 11WWell No. 3 ClawsonVirginia Drilling

Company

Contractor

COMPLETED

SECTION PLAT

C N L SE NW

 Ft. from N. Line990 Ft. from S. Line660 Ft. from E. Line Ft. from W. Line

SILICA POOL

	o		

Location Rig up

Drilling and Remarks:

Ar 8287
5" @ 8288
5000 acid
Pump 288 P.Y.

403 Gr

RECORD

Cased in., ft.Sand Gas Oil Total Depth 3318

PRODUCTION

1st 24 hrs. Nat. 1st 24 hrs. after shot Gas Cu. Ft.Dry Hole Abandoned

Date

APR 9 1941 19

S. J. LEWIS

Scout