

Form 51-5M-7-40-Palace


Section 17 Township 20 Range 11-W

Well No. #3 Clawson

Company Champlin Refining

NORTH

Clawson Pool

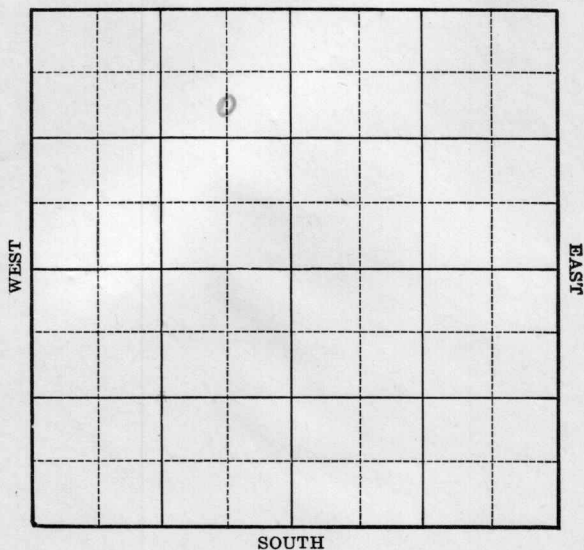


Sec. 17 Twp. 20 R. 11-WWell No. #3 Clawson FarmChamplin Refg. Company

(Clawson)

990 Ft. from N. Line Ft. from S. Line660 Ft. from E. Line Ft. from W. Line

Elev. 1777

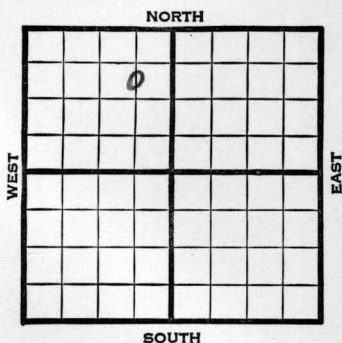

1940

REPORT

11/26

8" - 242' Anhy. 510'

Drlg. 1915'

12/5

Arb. 3303' 4" - 3330' T.D.

RUST.

12/12

36 shots 3306-18' 1500 acid.

Swab 7 bbls. per hour.

12/18

Arb. 3303'

4" - 3330'

T.D. 3330'

74 shots 3303-18'

3500 acid.

Depthograph potential 1772 bbls.

~~MAXIMUM~~ 40.2 Gravity.

COMPLETED

Map No. 46 Sec. 17 Twp. 20 R. 11WWell No. 3 Clawson

Champlin Refining

Company

Contractor

FIRST REPORT

C S L NE NW

990 Ft. from N. Line Ft. from S. Line660 Ft. from E. Line Ft. from W. Line

CLAWSON POOL

SECTION PLAT

	o		

Location Rig up

Drilling and Remarks:

8" - 242

Anhy. 510

1915 Drlg.

RECORDCased in., ft.Sand Gas Oil Total Depth **PRODUCTION**1st 24 hrs. Nat. 1st 24 hrs. after shot Gas Cu. Ft.Dry Hole Abandoned

Date

NOV 26 1940 19

S. J. LEWIS Scout

Map No. 46 Sec. 17 Twp. 20 R. 11WWell No. 3 ClawsonChamplin Refining Company


Contractor

COMPLETED

C S L N E N W

990 Ft. from N. Line Ft. from S. Line660 Ft. from E. Line Ft. from W. Line

CLAWSON POOL

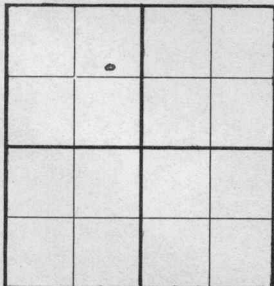SECTION PLATLocation Rig up

Drilling and Remarks:

*Ar 3303**4" C 3330**748 hots. 3303-18**3500 acud**Sept. 1772 Pst.**40 = Gr.***RECORD**Cased in., ft.Sand Gas Oil Total Depth 3300**PRODUCTION**1st 24 hrs. Nat. 1st 24 hrs. after shot Gas Cu. Ft.Dry Hole Abandoned

Date

DEC 18 1940 19

S. J. LEWIS Scout