


Section 17 Township 20 Range 11-W

Well No. #4 Clawson

Company Champlin Refining

Clawson Pool

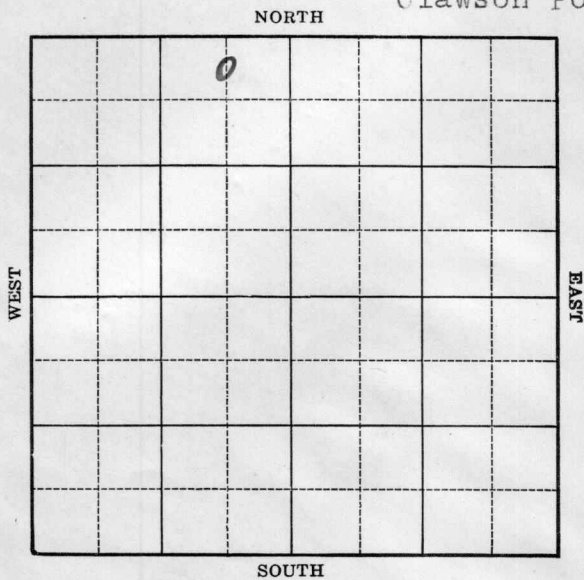


Sec. 17 Twp. 20 R. 11-WWell No. #4 Clawson FarmChamplin Refg. Company

(Clawson)

330 Ft. from N. Line Ft. from S. Line660 Ft. from E. Line Ft. from W. Line

Elev. 1777

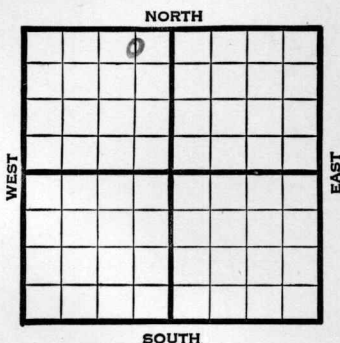

1940	REPORT
12/4	Location
12/12	"
12/19	"
12/26	Surface hole.
1941	
1/2	8" - 255' Anhy 58 5'
	Drl g. 27 50'
1/9	Arb. 3309-25' T.D.
	Sat. 3313-25' 4" - 3313' RUST.
1/16	T.D. 3330' 4500 acid.
1/22	Arb. 3309'
	4" - 3313'
	T.D. 3330'
	6500 acid.
	Potential 51 bbls., pump.
	40.3 Gravity
	COMPLETED

Map No. 46 Sec. 17 Twp. 20 R. 11WWell No. 4 Clawson

Champlin Refining Company

Contractor


FIRST REPORT

C N L NE NW

330 Ft. from N. Line Ft. from S. Line660 Ft. from E. Line Ft. from W. Line

CLAWSON POOL

SECTION PLAT

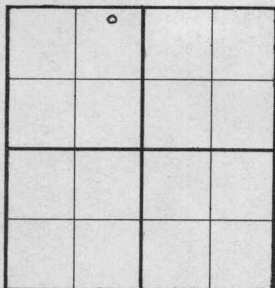Location XRig up

Drilling and Remarks:

RECORD

Cased in., ft.Sand Gas Oil Total Depth

PRODUCTION

1st 24 hrs. Nat. 1st 24 hrs. after shot Gas Cu. Ft.Dry Hole Abandoned

Date

DEC 4 1940 19

S. J. LEWIS Scout

Map No. 46 Sec. 17 Twp. 20 R. 11WWell No. 4 ClawsonChamplin Refining Company

Contractor

COMPLETED**SECTION PLAT**

C N L NE NW

330 Ft. from N. Line Ft. from S. Line660 Ft. from E. Line Ft. from W. Line

CLAWSON POOL

Location Rig up

Drilling and Remarks:

*Core 83309**4" @ 3312**6500 each**Pump 51 Pay**403 Gr.***RECORD**Cased in., ft.Sand Gas Oil Total Depth 3330**PRODUCTION**1st 24 hrs. Nat. 1st 24 hrs. after shot Gas Cu. Ft.Dry Hole Abandoned

Date

JAN 22 1941 19S. J. LEWIS Scout