


KANSAS Rice

Section 32 Township 18 Range 9W

Well No. #1 Ehly

Company Birmingham & Gartlett
Ploog Pool

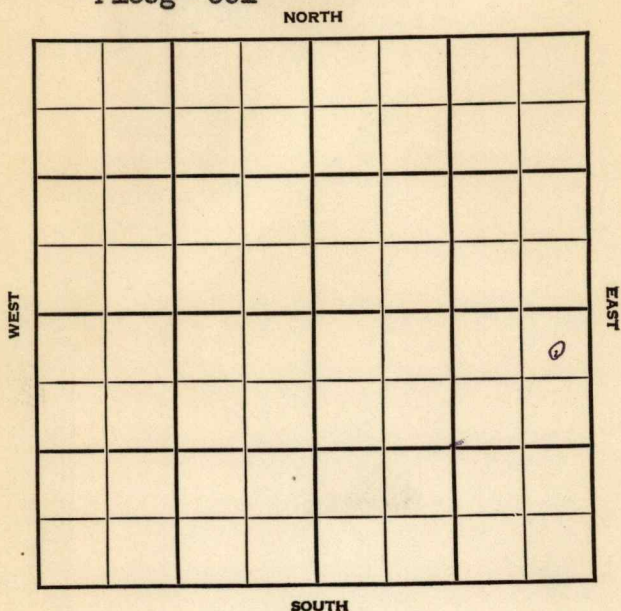

Rice KANSAS ✓

Sec. 32 Twp. 18 R. 9W

Well No. #1 Ehly Farm


Birmingham & Bartlett Company
Ploog

330 Ft. from N. Line

 Ft. from S. Line

330 Ft. from E. Line

 Ft. from W. Line

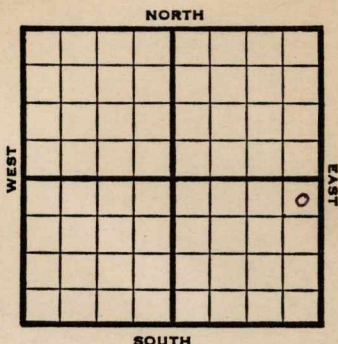

NE SE

1948

Elev. 1718' REPORT

4/7 9" @ 198'

WOC

4/14 Drlg. 2947'

4/21 Lansing 2893'
Arbuckle 3255'

TD 3260'

5" @ 3258'

4/28 TD 3270'

Shot 10 qts. of Marbles 3264-69'
CO

5/5 Arbuckle 3255'

5" @ 3258'

250 Acid

Pump 40 oil Pot.

Gr. 41.8°

TD 3270'

COMPLETED

Map No. _____ Sec. 32 Twp. 18 R. 9W

Well No. 1 Ehly

Birmingham & Bartlett Company

FIRST REPORT

Contractor

NE SE

SECTION PLAT

330 Ft. from N. Line
330 Ft. from S. Line
330 Ft. from E. Line
_____ Ft. from W. Line

			o

Rice County

Location _____

Rig up _____

Drilling and Remarks:

9" @ 198 WOC

RECORD

Cased _____ in., _____ ft.
Sand _____
Gas _____
Oil _____
Total Depth _____

PRODUCTION

1st 24 hrs. Nat. _____
1st 24 hrs. after shot _____
Gas _____ Cu. Ft.
Dry Hole _____
Abandoned _____

Date

APR 7 1948 19 _____ S. J. LEWIS Scout

Map No. 45 Sec. 32 Twp. 18 R. 9W

Well No. 1 Ehly

Birmingham & Bartlett Company

COMPLETE

Contractor

NE SE

E 11718
SECTION PLAT

330 Ft. from N. Line

_____ Ft. from S. Line

330 Ft. from E. Line

_____ Ft. from W. Line

			0

Rice County

Location _____

Rig up _____

Drilling and Remarks:

Art 3205
5" 3205
2000 cu ft
Prod 40 oil Bdy

41 Ehly

RECORD

Cased _____ in., _____ ft.

Sand _____

Gas _____

Oil ☒ _____

Total Depth 8270

PRODUCTION

1st 24 hrs. Nat. _____

1st 24 hrs. after shot _____

Gas _____ Cu. Ft.

Dry Hole _____

Abandoned _____

Date

MAY 5 1948 19 S. J. LEWIS Scout