

KANSAS


FORM 51 5M 10-41 PETROL

Section 17 Township 20 Range 11-W

Well No. #3 ~~Gleason~~ *Selle*

Company Virginia Drlg.

Silica pool

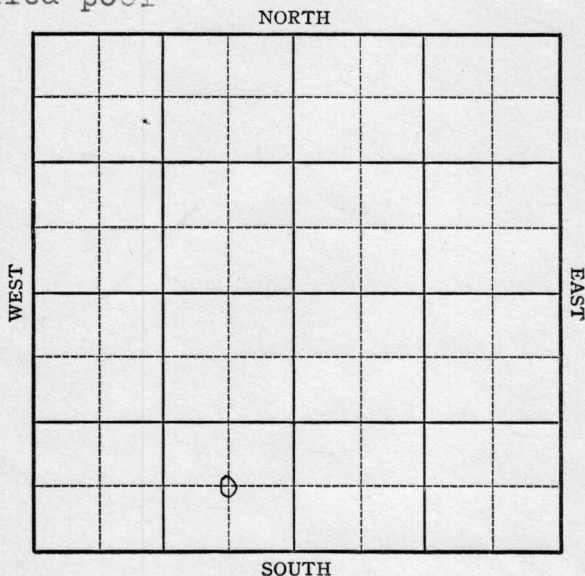

KANSAS

Barton

Sec. 17 Twp. 20 R. 11-W

Well No. #3 Selle Clawson Farm

Virginia Drilling Company


Silica Pool

 Ft. from N. Line

660 Ft. from S. Line

660 Ft. from E. Line

 Ft. from W. Line

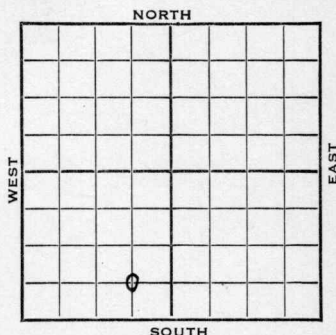

C SE SW 660 1785

1942

REPORT

12/9 Loc.

12/16 "

12/22 10" @ 132'
Anhy 525
Drlg. 1685'

12/29 Drlg. 2195

1943

1/6 Lans 3060
Drlg. 3195'.

1/13 Arb 3302
TD 3305 SD.

1/20 5" Casing set 3302' RUST.

" " " " "

1/27 " " " " "

2/3 " " " " "

2/10 100' oil per hr.

2/17 " " " "

2/24 TD 3306

1500' oil 24 hrs.

3/3 Arb. 3302

5" @ 3302'

T.D. 3306'

500 gal acid

Pump 412 Pot.

Gravity 44

COMPLETED

Barton

KANSAS

Map No. 46 Sec. 17 Twp. 20 R. 11WWell No. 3 Clawson

Virginia Drilling Company
FIRST REPORT
Contractor

C SE SW

 Ft. from N. Line660 Ft. from S. Line660 Ft. from E. Line Ft. from W. Line

SECTION PLAT

	o		

SILICA POOL

Location XXXRig up

Drilling and Remarks:

RECORD

Cased in., ft.Sand Gas Oil Total Depth

PRODUCTION

1st 24 hrs. Nat. 1st 24 hrs. after shot Gas Cu. Ft.Dry Hole Abandoned

Date

DEC 9 1942

19

S. J. LEWIS

Scout

Barton

Map No. 46 Sec. 17 Twp. 20 R. 11WWell No. 3 Selle

Virginia Drilling


Company

CORRECTION

Contractor

C SE SW

SECTION PLAT

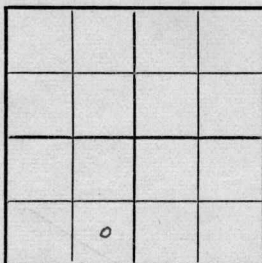

_____ Ft. from N. Line

660 Ft. from S. Line660 Ft. from E. Line

_____ Ft. from W. Line

SILICA POOL

Location _____

Rig up _____

Drilling and Remarks:

Reported as

#3 Clawson

RECORD

Cased _____ in., _____ ft.

Sand _____

Gas _____

Oil _____

Total Depth _____

PRODUCTION

1st 24 hrs. Nat. _____

1st 24 hrs. after shot _____

Gas _____ Cu. Ft.

Dry Hole _____

Abandoned _____

Date

DEC 16 1942

19

S. J. LEWIS

Scout

KANSAS

Barton

Map No. 46 Sec. 17 Twp. 20 R. 11WWell No. 3 Selle

Virginia Drilling


Company

COMPLETED

Contractor

C SE SW

SECTION PLAT

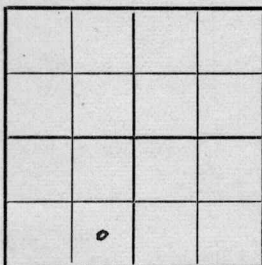

_____ Ft. from N. Line

660 Ft. from S. Line660 Ft. from E. Line

_____ Ft. from W. Line

SILICA POOL

Location _____

Rig up _____

Drilling and Remarks:

*Cor 83302.**5" 83302**500 ac 1**Pump 412 Pst.**440 ft*

RECORD

Cased _____ in., _____ ft.

Sand _____

Gas _____

Oil _____

Total Depth 3306

PRODUCTION

1st 24 hrs. Nat. _____

1st 24 hrs. after shot _____

Gas _____ Cu. Ft.

Dry Hole _____

Abandoned _____

Date

MAR 3 1943 19

S. J. LEWIS Scout