

KANSAS


FORM 51 5M 1-42 PETROL

Barton

Section 17 Township 20 Range 11-W


Well No. #2 Herter "A"

Company Virginia Drlg.

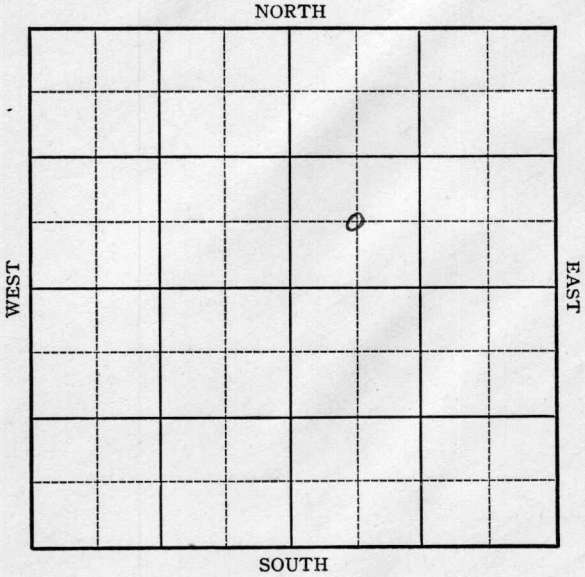

Sec. 17 Twp. 20 R. 11-WWell No. #2 Herter "A" FarmVirginia Drlg. Company

NORTH

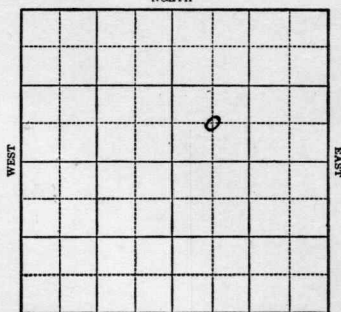

SOUTH

 Ft. from N. Line660 Ft. from S. Line Ft. from E. Line660 Ft. from W. LineElev. 1775

1943

R E P O R T

9/29

8" @ 300'

Drlg. 1546'

10/6

Drlg. 1560'

10/13

T.D. 2340 skid

Rig 35' East

10/20

10" @ 170

Anky 500

Drlg. 1470'

10/27

Drlg. 3045'

11/3

Lans 3056

Arb 3303'

T.D. 3306 SO

5" @ 3303

R_{sut}

11/10

SD repairs

11/17

" "

11/24

" "

12/1

" "

12/8

" "

12-15

" "

12-22

TD 3307'

2540' oil

12/29

"

1944

1-5

" "

OVER

1944

1-12 TD 3307'
2540' oil

1/19 " "

1/26 5" @ 3303
Arb 3303
TD 3307
Pump 400 Pot.
Gravity 41.6


COMPLETED

KANSASMap No. 46 Sec. 17 Twp. 20 R. 11WWell No. 2 Herter "A"Virginia Drlg.

Company

FIRST REPORT

Contractor

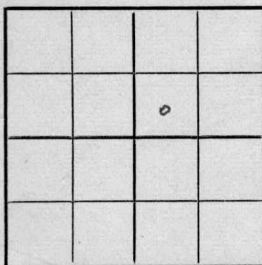C SW NE**SECTION PLAT**

Ft. from N. Line

660 Ft. from S. Line

Ft. from E. Line

660 Ft. from W. LineSilica Pool

Location

Rig up

Drilling and Remarks:

8" - 300
1546**RECORD**

Cased _____ in., _____ ft.

Sand _____

Gas _____

Oil _____

Total Depth _____

PRODUCTION

1st 24 hrs. Nat. _____

1st 24 hrs. after shot _____

Gas _____ Cu. Ft.

Dry Hole _____

Abandoned _____

Date

SEP 29 194319S. J. LEWIS

Scout

Barton

KANSAS

Map No. 46 Sec. 17 Twp. 20 R. 11WWell No. 2 Herter "A"

Virginia Drlg.

Company

COMPLETED

Contractor

C SW NE

SECTION PLAT

		o	

Ft. from N. Line

660

Ft. from S. Line

Ft. from E. Line

660

Ft. from W. Line

Silica Pool

Location

Rig up

Drilling and Remarks:

*Ar 8303**5' @ 8303**Run 400 ft.**41 1/2 ft*

RECORD

Cased _____ in., _____ ft.

Sand _____

Gas _____

Oil _____

Total Depth *8303*

PRODUCTION

1st 24 hrs. Nat. _____

1st 24 hrs. after shot _____

Gas _____ Cu. Ft.

Dry Hole _____

Abandoned _____

Date

JAN 26 1944

19

S. J. LEWIS Scout