FORM 51 25M 3-49 PETROL

KANSAS

Rice

Section 32 Township 18 Range 9W

Well No. 2 Charter

Company Birmingham & Bartlett

Ploog

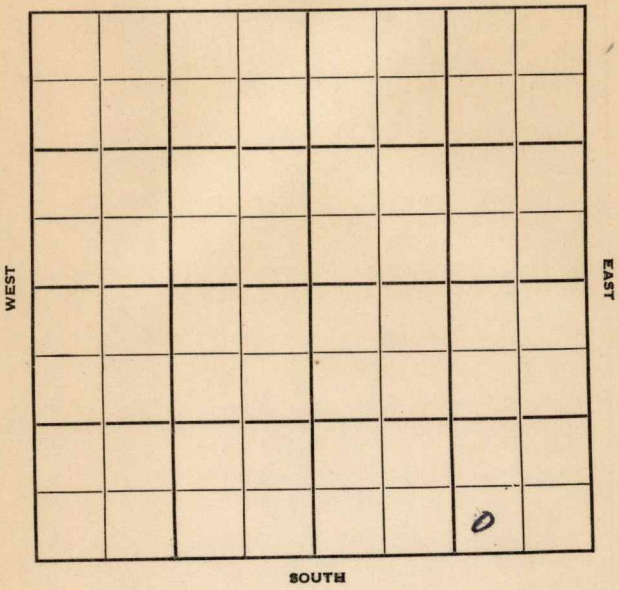

FORM 252-A
5M 10-48 PETROL

KANSAS

Rice

Sec. 32 Twp. 18 R. 9W

Well No. 2 Charter Farm

Birmingham & Bartlett Company

Birmingham & Bartlett Contr.

Ploog

Ft. from N. Line

330 Ft. from S. Line

990 Ft. from E. Line

Ft. from W. Line

SW SE SE

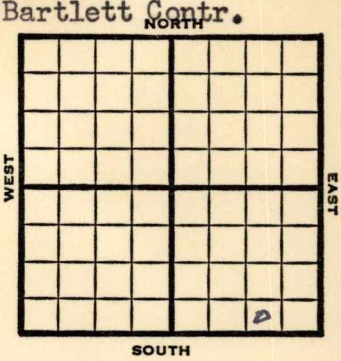

1949	REPORT
	Elev 1720'
7/27	8" @ 211
	Anhy 368
	2250
8/3	Lansing 2890'
	Drlg 3238'
8/10	Arb. 3244'
	5"@ 3245
	TD 3245'
8/17	TD 3254'
	Swb 5 bbls oil PH
8/24	"
8/31	"
9/7	"
9/14	TD 3254'
	Arb. 3244'
	5"@ 3245'
	Pump 16 Oil + 25% W Pot
	41° Gr.
	Comp
	COMPLETED

Form 26 200 Bks. 6-49 Petrol

Kansas

Ploog Pool

Map No. _____ Sec. 32 Twp. 18 R. 9W

Well No. 2 Charter

Birmingham & Bartlett Company

Birmingham & Bartlett Contractor

SW SE SE

FIRST REPORT

SECTION PLAT

_____ Ft. from N. Line

330 Ft. from S. Line

990 Ft. from E. Line

_____ Ft. from W. Line

Rice County

Location _____

Rig up _____

Drilling and Remarks:

8" @ 211
anhy 368
2250

RECORD

Cased _____ in., _____ ft.

Sand _____

Gas _____

Oil _____

Total Depth _____

PRODUCTION

1st 24 hrs. Nat. _____

1st 24 hrs. after shot _____

Gas _____ Cu. Ft.

Dry Hole _____

Abandoned _____

Date

JUL 27 1949 19

S. J. LEWIS Scout

Form 26 200 Bks. 6-49 Petrol

Kansas

Ploog Pool

Map No. K45 Sec. 32 Twp. 18 R. 9W

Well No. 2 Charter

Birmingham & Bartlett Company

COMPLETE Contractor

SW SE SE

El. 1720

SECTION PLAT

Ft. from N. Line

330 Ft. from S. Line

990 Ft. from E. Line

Ft. from W. Line

Rice County

Location

Rig up

Drilling and Remarks:

Ar 3244

5 Co 3245

Purge 16 oil + 25% W

Pot.

41° Gr

RECORD

Cased in., ft.

Sand

Gas

Oil

Total Depth 3254

PRODUCTION

1st 24 hrs. Nat.

1st 24 hrs. after shot

Gas Cu. Ft.

Dry Hole

Abandoned

Date

SEP 14 1949 19

S. J. LEWIS Scout