

KANSAS


Rice

Section 32 Township 18 Range 9W

Well No. 2 Ehly

Company Birmingham & Bartlett

Ploog

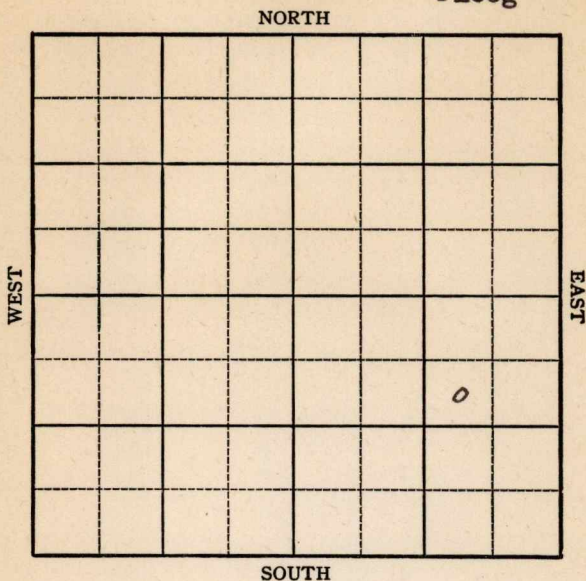

KANSAS

Rice

Sec. 32 Twp. 18 R. 9W

Well No. #2 Ehly Farm

Birmingham & Bartlett Company

Ploog Pool


990' Ft. from N. Line

 Ft. from S. Line

990' Ft. from E. Line

 Ft. from W. Line

SW NE SE

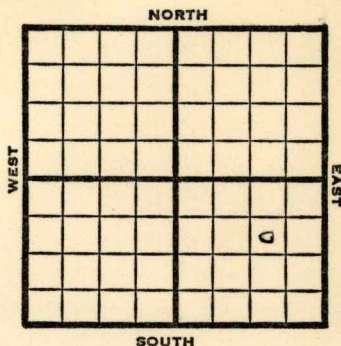

1949

lev 1721' REPORT

3/30 8" @ 211' ,
Drlg. 1495
4/6 **Lansing 2989'**
Arb. 3233'
TD 3236
5"@ 3233'
4/12 TD 3249'
150' oil 3hrs.
4/27 TD 3249'
Arb. 3233'
5"@ 3233'
Pump 70 Oil Pot
41 Gr.
Comp

COMPLETED

Kansas

Map No. _____ Sec. 32 Twp. 18 R. 9WWell No. 2 Ehly_____ Birmingham & Bartlett Company_____ **FIRST REPORT** Contractor

SW NE SE

SECTION PLAT

990 Ft. from N. Line

_____ Ft. from S. Line

990 Ft. from E. Line

_____ Ft. from W. Line

Rice County

			a

RECORD

Location _____

Cased _____ in., _____ ft.

Rig up _____

Sand _____

Drilling and Remarks:

Gas _____

Oil _____

8" @ 211

Total Depth _____

drlg. 1495

PRODUCTION

1st 24 hrs. Nat. _____

1st 24 hrs. after shot _____

Gas _____ Cu. Ft.

Dry Hole _____

Abandoned _____

Date

MAR 30 1949

19

S. J. LEWIS

Scout

Kansas

Map No. K45 Sec. 32 Twp. 18 R. 9WWell No. 2 EhleyBirmingham & Bartlett Company

COMPLETE

Contractor

SW NE SE

E1.1721
SECTION PLAT

			0

990 Ft. from N. Line Ft. from S. Line990 Ft. from E. Line Ft. from W. Line

Rice County

Location Rig up

Drilling and Remarks:

Per 32335" 3233Produce 70 oil 204.2 lb

RECORD

Cased in., ft.Sand Gas Oil Total Depth 3249

PRODUCTION

1st 24 hrs. Nat. 1st 24 hrs. after shot Gas Cu. Ft.Dry Hole Abandoned

Date

APR 20 1949

19

S. J. LEWIS

Scout

Sandy -

First Report Shows
this as #2

Advise

Foldie

RECORD	Location
Cased	Big up
Sand	Drilling and Remarks:
Gas	
Oil	
Total Depth	

Scout Cards	Scout
Land Small Map	
Land Wall Map	
Tracings	
France Map	
Pierce Map	
Misc.	