


Section 17 Township 20 Range 11-W

Well No. #1 ~~Kendrick~~ Mary Selle

Company Broderick & Gordon

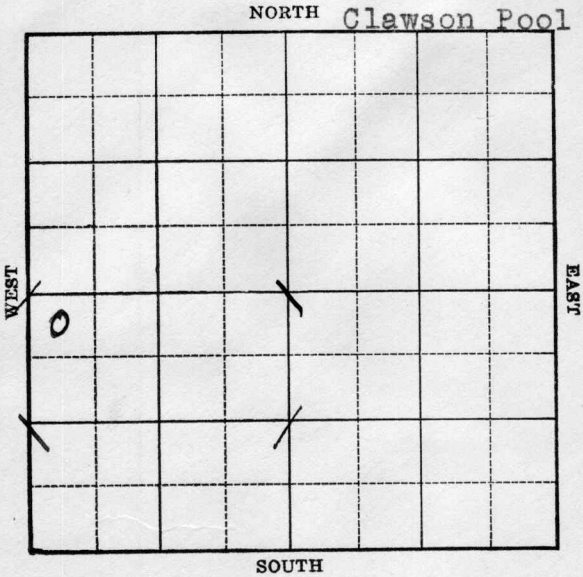

KANSAS


Barton

Sec. 17 Twp. 20 R. 11-WWell No. #1 ~~Kendrick~~ Mary Selle FarmBroderick & Gordon Company

(Clawson)

330 Ft. from N. Line Ft. from S. Line Ft. from E. Line330 Ft. from W. Line

Elev. 1787'

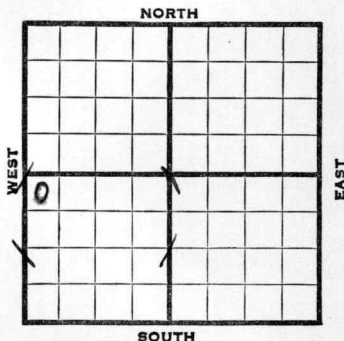

1939	REPORT
3/8	Mat'l.
3/17	R. R.
3/24	10" - 141' WOC.
3/31	Anhy 530' Drlg. 2510'
4/7	Lans. 3060' S. O. 3185-90'
	Arb. 3284-88' T.D. 5" - 3284'
	RUST.
4/14	Drilled plug to 3289' T.D.
	H.F.O. Bldg. tanks.
4/19	5" - 3284'
	Arb. 3284'
	T. D. 3289'
	Pump 319 bbls. 8 hours.
	Potential 957 bbls., Natural.
	COMPLETED

Barton

KANSAS

Map No. 46 Sec. 17 Twp. 20 R. 11WWell No. 1 KendrickBroderick & Gordon

Company


Contractor

FIRST REPORT

NW SW

330 Ft. from N. Line Ft. from S. Line Ft. from E. Line330 Ft. from W. Line

SECTION PLAT

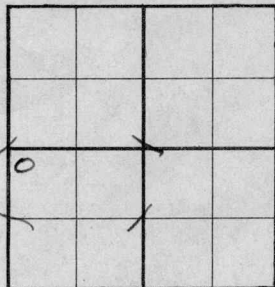

CLAWSON POOL

Location Rig up

Drilling and Remarks:

Matl.

RECORD

Cased in., ft.Sand Gas Oil Total Depth

PRODUCTION

1st 24 hrs. Nat. 1st 24 hrs. after shot Gas Cu. Ft.Dry Hole Abandoned

Date

MAR 8 - 1939

19

H. D. Hatfield Scout

Barton KANSAS

Map No. 46 Sec. 17 Twp. 20 R. 11 ^WWell No. 1 - Mary SelleBroderick & Gordon Company

Contractor

NW SW

SECTION PLAT

0			

330 Ft. from N. Line

_____ Ft. from S. Line

_____ Ft. from E. Line

330 Ft. from W. Line

CORRECTION

Location _____

Rig up _____

Drilling and Remarks:

*Farm Name changed
From Kendrick
To Mary Selle*

RECORD

Cased _____ in., _____ ft.

Sand _____

Gas _____

Oil _____

Total Depth _____

PRODUCTION

1st 24 hrs. Nat. _____

1st 24 hrs. after shot _____

Gas _____ Cu. Ft.

Dry Hole _____

Abandoned _____

Date

MAR 22 1939 19

H. D. Hatfield

Scout

Map No. 46 Sec. 17 Twp. 20 R. 11WWell No. 1 Mary SelleBroderick & Gordon Company

Contractor

COMPLETED

SECTION PLAT

0			

NW SW
330 Ft. from N. Line

Ft. from S. Line

Ft. from E. Line

330 Ft. from W. Line

CLAWSON POOL

Location _____

Rig up _____

Drilling and Remarks:

RECORD

Cased 5 in., 3284 ft.Sand Arb 3284

Gas _____

Oil _____

Total Depth 3289

PRODUCTION

1st 24 hrs. Nat. _____

1st 24 hrs. after shot _____

Gas _____ Cu. Ft.

Dry Hole _____

Abandoned _____

Date

APR 19 1939

19

H. D. Hatfield

Scout