


Section 22 Township 18 Range 9W

Well No. #1 Leach

Company Aylward Production

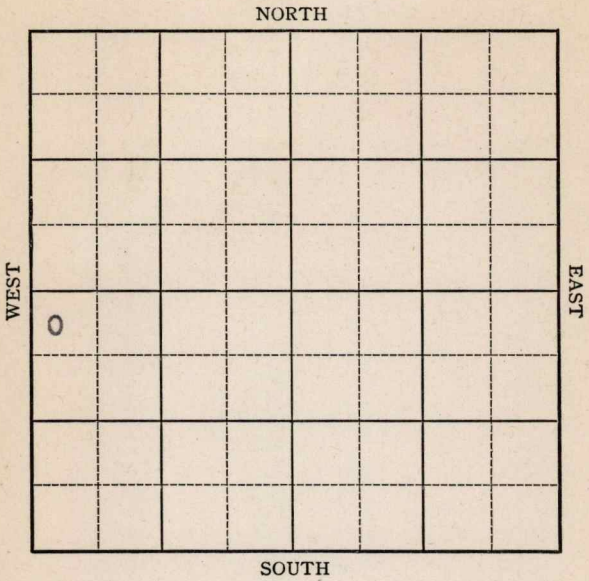

Sec. 22 Twp. 18 R. 9-W

Well No. #1 Leach Farm

Aylward Production

Company


(Richards)

330 Ft. from N. Line

\_\_\_\_\_ Ft. from S. Line

\_\_\_\_\_ Ft. from E. Line

330 Ft. from W. Line

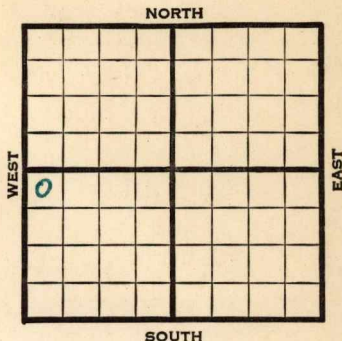

**Elev. 1722**

1941	REPORT
9/3	R.U.R.
9/11	10" - 185' Drlg. 1787'
9/18	<b>Anhy 375'</b> T.D. 3225' Run 5".
9/25	5" - 3225' RUST.
10/2	" " "
10/9	T.D. 3262' 2000' oil.
10/15	<b>Cong. 3250'</b>
	5" - 3225'
	T.D. 3262'
	30' of 5" liner 3245'
	Potential 535 bbls., pump.
	<b>COMPLETED</b>

**KANSAS**

Map No. 45 Sec. 22 Twp. 18 R. 9W

Well No. 1 Leach

Aylward Production Company

FIRST REPORT Contractor

**SECTION PLAT**

NW SW

330 Ft. from N. Line

\_\_\_\_\_ Ft. from S. Line

\_\_\_\_\_ Ft. from E. Line

330 Ft. from W. Line

o			

RICHARDS POOL

Location \_\_\_\_\_

Rig up \_\_\_\_\_

Drilling and Remarks:

Rigging up Roty.

**RECORD**

Cased \_\_\_\_\_ in., \_\_\_\_\_ ft.

Sand \_\_\_\_\_

Gas \_\_\_\_\_

Oil \_\_\_\_\_

Total Depth \_\_\_\_\_

**PRODUCTION**

1st 24 hrs. Nat. \_\_\_\_\_

1st 24 hrs. after shot \_\_\_\_\_

Gas \_\_\_\_\_ Cu. Ft.

Dry Hole \_\_\_\_\_

Abandoned \_\_\_\_\_

Date

SEP 3 1941 19

S. J. LEWIS Scout

Map No. K-45 Sec. 22 Twp. 18 R. 9W

Well No. 1 Leach

Aylward Production Company

COMPLETED Contractor

NW SW

**SECTION PLAT**

330 Ft. from N. Line

\_\_\_\_\_ Ft. from S. Line

\_\_\_\_\_ Ft. from E. Line

330 Ft. from W. Line

6			

**RICHARDS POOL**

Location \_\_\_\_\_

Rig up \_\_\_\_\_

Drilling and Remarks:

*Core 3250  
Core 3225  
30' of 5" liner 3245.  
Pump 535 BX*

**RECORD**

Cased \_\_\_\_\_ in., \_\_\_\_\_ ft.

Sand \_\_\_\_\_

Gas \_\_\_\_\_

Oil \_\_\_\_\_

Total Depth 3262

**PRODUCTION**

1st 24 hrs. Nat. \_\_\_\_\_

1st 24 hrs. after shot \_\_\_\_\_

Gas \_\_\_\_\_ Cu. Ft.

Dry Hole \_\_\_\_\_

Abandoned \_\_\_\_\_

Date

**OCT 15 1941**

19

**S. J. LEWIS**

Scout