


Section 19 Township 20 Range 11-W

Well No. #3 Andrea

Company Hollow Drilling

NORTH

Clawson Pool

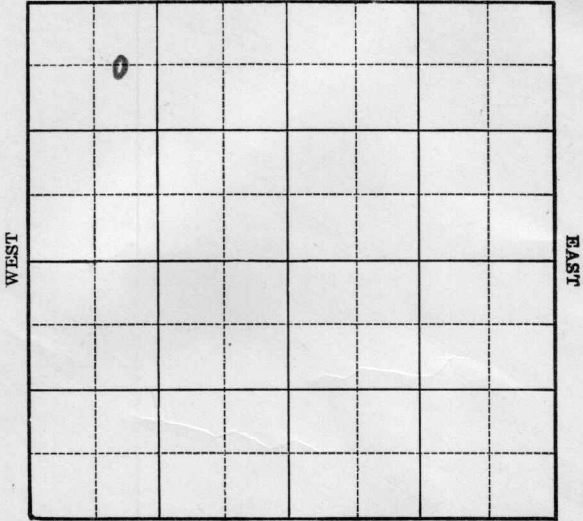

SOUTH

Sec. 19 Twp. 20 R. 11-W

Well No. #3 Andrea Farm

Hollow Drilling

Company

(Clawson)


66 0 Ft. from N. Line

Ft. from S. Line

Ft. from E. Line

990 Ft. from W. Line

Elev. 1793

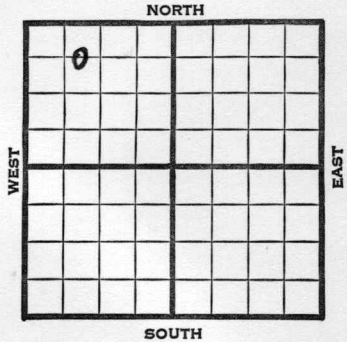

1941	REPORT
2/26	Derrick.
3/6	8" - 245' Anhy 540'
	Drl g. 1530'
3/13	Lans. 3081' Arb. 3303-04' T.D. Run 5".
3/20	T.D. 3343' 500 acid. 5" - 3303'
3/27	" "
4/2	Arb. 3327' 5" - 3303' T.D. 3343' 500 acid. Potential 263 bbls., pump. 45. Gravity <u>COMPLETED</u>

Map No. 46 Sec. 19 Twp. 20 R. 11WWell No. 3 AndreaHollow Drilling Company**FIRST REPORT**

Contractor

C E L NW NW

660 Ft. from N. Line Ft. from S. Line Ft. from E. Line990 Ft. from W. Line

CLAWSON POOL

SECTION PLAT

0			

Location Rig up Drilling and Remarks:
Derrick**RECORD**Cased in., ft.Sand Gas Oil Total Depth **PRODUCTION**1st 24 hrs. Nat. 1st 24 hrs. after shot Gas Cu. Ft.Dry Hole Abandoned

Date

FEB 26 1941 19S. J. LEWIS Scout

Map No. 46 Sec. 19 Twp. 20 R. 11WWell No. 3 AndreaHollow Drilling

Company

Contractor

COMPLETED

SECTION PLAT

o				

C E L NW NW

660 Ft. from N. Line

Ft. from S. Line

Ft. from E. Line

990 Ft. from W. Line

SILICA POOL

Location

Rig up

Drilling and Remarks:

*At 3827**5" casing**500 cu ft**Pump 263 BT**450 Gr.*

RECORD

Cased _____ in., _____ ft.

Sand _____

Gas _____

Oil _____

Total Depth 3343

PRODUCTION

1st 24 hrs. Nat. _____

1st 24 hrs. after shot _____

Gas _____ Cu. Ft.

Dry Hole _____

Abandoned _____

Date

APR 2 1941

19

S. J. LEWIS

Scout