


Map No. 1-189 **KANSAS** Sec. 33 Twp. 18 R. 9^w
 Well No. 1-189 Tatlock, Ital Farm _____ Company _____

NORTH

WEST

EAST

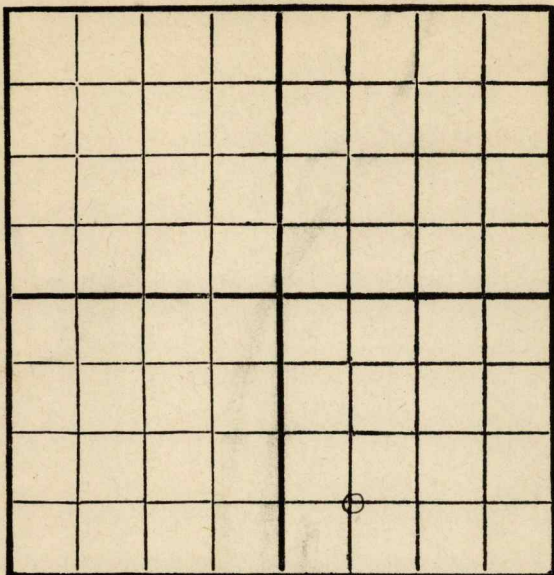

SOUTH

Location _____

Drilling Remarks _____

Rig Up _____

Drilling Remarks _____

RECORD

Cased _____ in. _____ ft.

Sand _____

Gas _____

Oil _____

Total Depth _____

PRODUCTION

1st 24 hrs. Nat. _____

1st 24 hrs. after shot _____


Gas _____ cu. ft. _____

Dry Hole _____

Abandoned _____

Map No. Rice **KANSAS** Sec. 33 Twp. 18 R. 9^w
 Well No. 1- Ploog Farm
Satlock et al Company

 Ft. from N. Line
660 Ft. from S. Line
 Ft. from E. Line
660 Ft. from W. Line

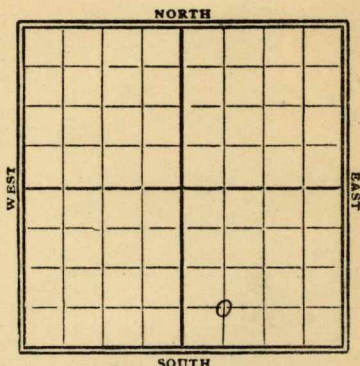

1929

Date	REPORT
11/13	Bldg Rig
11/20	4/22 Rig
11/27	4/9
12/4	4/16 - Rign up.
12/11	4/23 - Spud &
12/18	S. D.
12/23	4/30 - 90' Log
12/30	24" pipe
1930	5/7
1/8	5/14 - Hrlg 330'
1/15	5/21 - " ~~1850'~~
1/22	5/28 - " 1250'
1/29	6/4 - " 1650'
2/5	6/11 " 2000'
2/12	6/18 " 2080'
2/19	6/25 - Log bit
2/26	20200
3/5	Rig 7/2 - Hrlg 2350'
3/12	
3/19	(orer)
3/26	

7/9- Ldg. out 3440.

7/16- Lrdg. 2995'

7/23- set 8"- 3170

Top pay 3270

T.D. 3270 Bailed
yesterday about
5 bbl oil per hour
Now 1800' oil in hole
Hole caving some
Will run 6" liner
and test

46° gravity oil
(Think may be in
siliceous lime)

7/30- Siliceous ³²⁴⁹~~3449~~ -
~~3452~~ T.D. 3252 (S.L.M.)
swabbed 100 bbls
24 hrs

8/6- S.D. ^{3252'}~~3452~~

8/9- Top Silc lime 3249

T.D. 3253' (one ft deeper)

Made 189 bbl 1st 6 hr

" 185 " 2nd 6 "

No water

46° gravity
8/15- T.D. 3253

Swab 199 bbls. from 1:00 to 2:00 PM

" 172 " " 2:00 to 3:00 "

" 165 " " 3:00 to 4:00 "

Swabbing about 500 ft
from top of hole

Map No. 15 Sec. 33 Twp. 10 R. 9

Well No. 1009 Farm

Patlock Mail Company

NORTH

Ft. from N. Line

Ft. from S. Line

Ft. from E. Line

Ft. from W. Line

WEST

EAST

SOUTH

Date _____

REPORT

Land 3249-53

TD 3253

Flow 723 vol. 24 hr

sywa 712 " 4 "

Est 3000 bbl well

Spent in

Comp

Rice
 Map No. **KANSAS** Sec. *33* Twp. *18* R. *9W*

45
 Well No. *1 Plot 9*

Tatlock & Co Company

Contractor

SECTION PLAT

.....Ft. from N. Line

660.....Ft. from S. Line

.....Ft. from E. Line

660.....Ft. from W. Line

FIRST REPORTS

Location.....

Rig up.....

Drilling and Remarks:

Building rig

RECORD

Cased.....in., ...ft.

☒ Sand.....

☒ Gas.....

Oil.....

Total Depth.....

PRODUCTION

1st 24 hrs. Nat.

1st 24 hrs. after shot.....

Gas.....Cu. Ft.

Dry Hole.....

Abandoned.....

Date

NOV 13 1929

192

S. J. LEWIS

Scout

45 **KANSAS** Rice
 Map No. _____ Sec. 33 Twp. 18 R. 9 ^W

Well No. 1 Phlog
Jatlock et al Company _____

Contractor _____

COMPLETE**SECTION PLAT**

		0	

_____ Ft. from N. Line

660 Ft. from S. Line

_____ Ft. from E. Line

660 Ft. from W. Line

Location _____

Rig up _____

Drilling and Remarks:

flowed 723 bls 24 hrsswabbed 712 bls 4 hrs.Est 3000 BlsShut in.**RECORD**

Cased _____ in., _____ ft.

Sand 3249-3253

Gas _____

Oil 3253Total Depth 3253**PRODUCTION**

1st 24 hrs. Nat. _____

1st 24 hrs. after shot _____

Gas _____ Cu. Ft.

Dry Hole _____

Abandoned _____

Date

AUG 20 1930

19

CHAS. L. SHERWOOD

Scout