


DX 78-1 Rice

KANSAS

Section 33 Township 18 Range 9W

Well No. #1 Ploog "A"

Company *Carl Lebsack*
~~D. R. Ackley & L. E. Quinlan~~

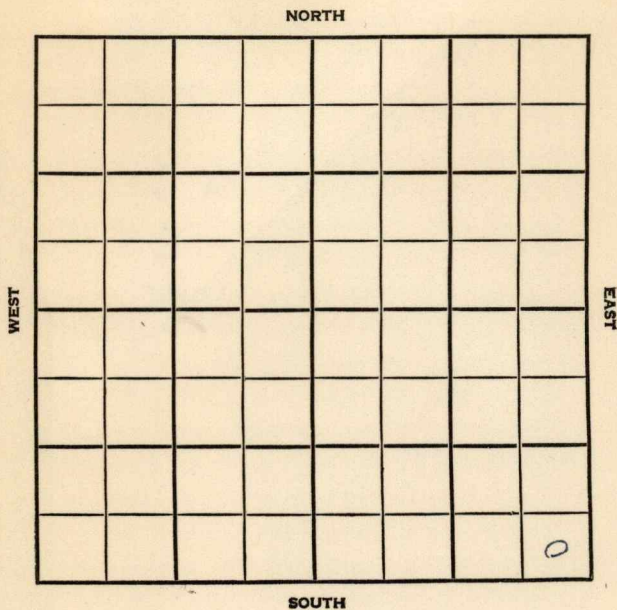

Rice

KANSAS

SEC. 33	TWP. 18	R. 9W
------------	------------	----------

WELL NO. #1 Ploog "A" FARM

COMPANY *Carl Lebsack*
~~D.R. Aekley & L.E. Quinlan~~

CONTRACTOR


Chase-Silica

_____ FT. FROM N. LINE

_____ FT. FROM S. LINE

_____ FT. FROM E. LINE

_____ FT. FROM W. LINE

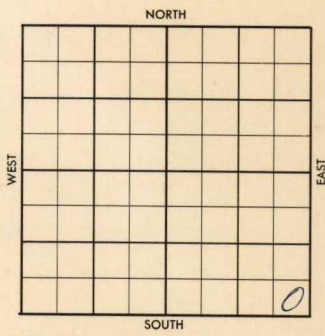

SE SE SE

Shell - F0

	ELEVATION	REPORT
1956	1724'	

7-3

Location

8-15

Spud 7-16-56

DST 3214-40 op 1 hr. rec. 680' oil / 120' mdy oil, BHP 730#/20".

5 1/2" @ 3285 w/100

CO 25/3234-40

S/ 8 1/2 boph, no/wtr., 13 hrs.

P/ 45 bopd, no/wtr.

H. 2743'; L. 2899'; C. 3220';

S. 3247'; A. 3280';

TD 3286'

COMPLETED

12

County Rice Elev. _____

Sec. 33 Twp. 18 Rge. 9W

Company D. R. Ackley & L. E. Quinlan

Farm Name Floog "A" No. 1

TOPS	DEPTH	LOG	DATUM
Anh.			
Tr.			
H.			
Tr.			
Dg.			
BL.			
L.			
K.C.			
B.K.C.			
Ce.			
C.			
M.			
M.			
K.			
Mz.			
Mo.			
V.			
S.			
S.			
A.			
R.			
Pe.			
G.			
T.D.			

Loc. in Sec. SE SE SE

Geol. _____

Contr. _____

Pool Chase-Silica

JUL 3 56

FIRST REPORT

Date Comm. Shell - FO

Location _____

JUL 1 1956

R.G.

Co.
Lse.
No.
Sec.
T.
R.

CORRECTION

FORM 513 SUNRAY

County Rice Elev. 1724
 Sec. 33 Twp. 18 Rge. 9W
 Company Carl Lebsack D. R. Ackley & L. E. Quinlan
 Farm Name Flood "A" No. 1

TOPS	DEPTH	LOG	DATUM	Loc. in Sec.
Anh.				SE SE SE
Top.				
H.	2743			
Tr.				
Dg.				
Bl.				
L.	2899			Geol.
K.C.				Contr.
B.K.C.				
Ce.				
C.	3220			
M.				Pool
M.				Chase-Silica
K.				
Mz.				
Ma.				
V.				
S.	3247			<div style="border: 1px solid black; padding: 5px; display: inline-block;"> <p style="font-size: 2em; margin: 0;">COMPLETE</p> <p style="margin: 0;">AUG 15 '56</p> </div>
S.				
A.	3280			
R.				
PE.				
G.				
T.D.	3286			0

Date Comm. 8/8 210 Shell - 70

Location JUL 11 '56 JUL 18 '56 7-16-56
JUL 25 '56 DST 3214-40 1hr run
680' oil + 120' Mdy oil BHP 730
120" 5 1/2 @ 3285/100 AUG 1 '56
co 25/3234-40 @ 8 1/2 Boph
no/w 13 hrs AUG 8 '56
45 Boph no/w str AUG 15 '56 P