

Section 19 Township 20 Range 11-W

Well No. #2 Fenko *(Senko)*

Company R. L Williams
Kowlasky Pool

NORTH

	0						

WEST

EAST

SOUTH

KANSAS

Barton ✓

Sec. 19 Twp. 20 R. 11W

Well No. #2 Fenko Farm
R. L. Williams Company

Kowlasky Pool


_____ Ft. from N. Line

330' Ft. from S. Line

_____ Ft. from E. Line

990' Ft. from W. Line

SE SW SW

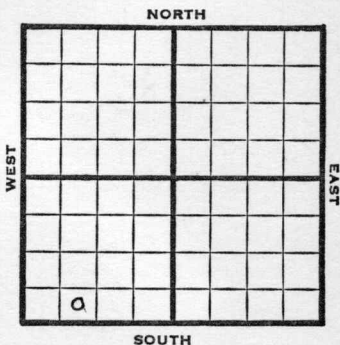

1948

Eli 1805'

REPORT

7/8 Drlg. 1805'
 7/14 8" @ 250'
 Drlg 2275'
 7/21 TD 3388' in Cong.
 Lansing 3123'
 Cong 3349'
 Aband.

ABANDONED

Map No. _____ Sec. 19 Twp. 20 R. 11W

Well No. 2 Fenko

R. L. Williams Company

FIRST REPORT

Contractor

SE SW SW

SECTION PLAT

_____ Ft. from N. Line

330 Ft. from S. Line

_____ Ft. from E. Line

990 Ft. from W. Line

Barton County

Location _____

Rig up _____

Drilling and Remarks:

drlg. 1805

RECORD

Cased _____ in., _____ ft.

Sand _____

Gas _____

Oil _____

Total Depth _____

PRODUCTION

1st 24 hrs. Nat. _____

1st 24 hrs. after shot _____

Gas _____ Cu. Ft.

Dry Hole _____

Abandoned _____

Date

JUL 8 1948

19

S. J. LEWIS

Scout

Map No. 46 Sec. 19 Twp. 20 R. 11W

Well No. 2 Senko

R. L. Williams Company

ABANDONED

SE SW SW

Contractor

E. 1805
SECTION PLAT

 Ft. from N. Line

330 Ft. from S. Line

 Ft. from E. Line

990 Ft. from W. Line

0			

Barton County

Location

Rig up

Drilling and Remarks:

*Lease 3123
Cong 3349*

RECORD

Cased in., ft.

Sand

Gas

Oil

Total Depth 988' in Cong

PRODUCTION

1st 24 hrs. Nat.

1st 24 hrs. after shot

Gas Cu. Ft.

Dry Hole

Abandoned

Date

JUL 21 1948

19

S. J. LEWIS Scout