

Barton


DX 78-1

Section 20 Township 20 Range 11 WWell No. #1 GrantCompany Isern Drlg. & F. G. Hool

NORTH

WEST

EAST

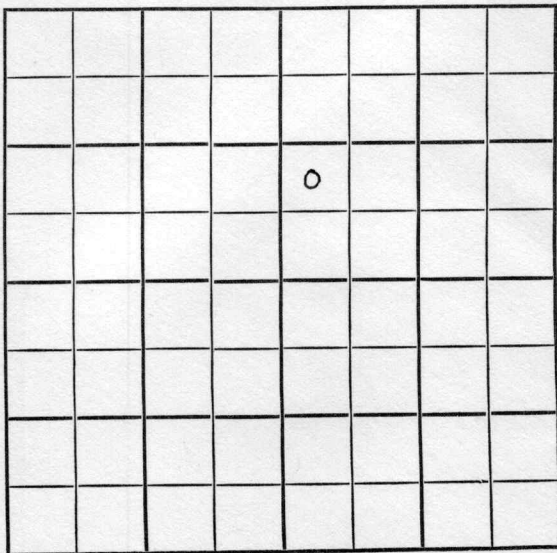

SOUTH

Barton

KANSAS

SEC.	TWP.	R.
20	20	11W
WELL NO.		

#1 Grant

FARM

COMPANY

Isern Drlg. & F. G. Holl

CONTRACTOR

Isern

Hagen


Ft. from N. Line

Ft. from S. Line

Ft. from E. Line

Ft. from W. Line

NW SW NE

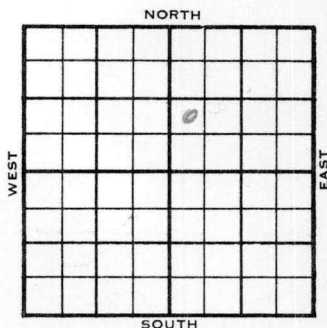

	ELEVATION	REPORT
1955	1788'	
7/20	Spdg.	
9-7	8 5/8" @ 253/225	
	DST 3327-35, open 1 hr., rec 120' ocm	
	100/20"	
	DST 3335-43, open 1 hr., rec 780' oil	
	710/20"	
	TD 3343	
	5" @ 3335 , CO to 3343 S/ 6 boph 6 hr.	
	Comp 50 bopd	
	TOPS	DEPTH
	Anh.	532
	H.	2940
	B.L.	3067
	L.	3084
	A	3327
	T.D. 3343'	

COMPLETED

County Barton Elev. _____
Sec. 20 Twp. 20 Rge. 11W
Company Isern Drlg. & F. G. Holl
FarmName Grant No. 1

TOPS	DEPTH	LOG	DATUM
Anh.			
TP.			
H.			
Tr.			
Dg.			
BL.			
L.			
K.C.			
B.K.C.			
Ce.			
C.			
M.			
M.			
K.			
Mz.			
Mq.			
V.			
S.			
S.			
A.			
R.			
PE.			
G.			
T.D.			

Loc. in Sec. NW SW NE

Geol. _____

Contr. Isern

Pool Hagen

FIRST REPORT
JUL 20 '55

Date Comm. spdg.

13

County Barton Elev. 1788 Co. Co.
 Sec. 20 Twp. 20 Rge. 11W
 Company Isern Drlg. & F. G. Holl
 Farm Name Grant No. 1

TOPS	DEPTH	LOG	DATUM	Loc. in Sec.
Anh.	532			NW SW NE
Tr.				
H.	2940		1152	
Dg.				
BL.	3067		1279	
L.	3084		1296	Geol.
K.C.				Contr.
B.K.C.				Isern
Ce.				Pool
C.				Hagen
M.				
M.				
K.				
Mz.				
Mq.				
V.				
S.				
S.				
A.	3327		1539	
R.				
PE.				
G.				
T.D.	3343			

Date Comm. 7-19-55 SEP 7 1955

8 5/8" @ 253/225 DST 3327-35 open 1 hr

Rec. 120' ocm 100/20" DST 3335-43

open 1 hr. Rec. 780' oil 710/20"

TD 3343 5" @ 3335 CO to 3343

S/ 6 boph 6 hr. Comp. 50 bopd

