

Union Oil & Royalty Company

NORTH

WEST

EAST

SOUTH

Location _____
Drilling Remarks _____

Rig Up-----
Drilling Remarks

RECORD


Cased _____ in. _____ ft.
 Sand _____
 Gas _____
 Oil _____
 Total Depth _____

PRODUCTION

1st 24 hrs. Nat. _____
1st 24 hrs. after shot _____
Gas _____ cu. ft. _____
Dry Hole _____
Abandoned _____

Map No. **KANSAS** Sec. **22** Twp. **18** R. **9W** *Rice*
Well No. **1- Ricard** Farm
Union Oil & Royalty Company

NORTH

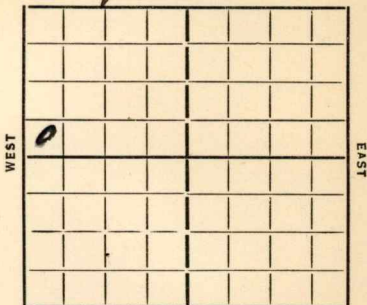

Ft. from N. Line

330

Ft. from S. Line

Ft. from E. Line

330

Ft. from W. Line

1721

SOUTH

Date

REPORT

7/18 Location
7/18
8/8 dly 290
8/15 " 1600
8/22 2095 run 10"
8/29 dly 2660 10" 2218
9/6 6" 3201 to 30 70-80
dly 3265 strip 3254
dly 50/5 hrs.
9/25 dly 3324
TJ 3400
PB 3365
201 Oil
37 Water.

COMPLETED

Map No. 45 Sec. 22 Twp. 18 R. 9WWell No. 1 - Richard
Union Oil & Royalty Company

Contractor

FIRST REPORTS

SECTION PLAT

0			

Ft. from N. Line

330 Ft. from S. Line

Ft. from E. Line

330 Ft. from W. Line

RECORD

Location

Cased in., ft.

Rig up

Sand

Drilling and Remarks:

Gas

Oil

Total Depth

PRODUCTION

1st 24 hrs. Nat.

1st 24 hrs. after shot

Gas Cu. Ft.

Dry Hole

Abandoned

Date

ORVAL MANNSCHRECK

7-10-35 192

Scout

KANSAS

Map No. 45 Sec. 22 Twp. 18 R. 9WWell No. 1- RichardUnion Oil Roy. et al Company

Contractor

COMPLETED

SECTION PLAT

0			

Ft. from N. Line

330 Ft. from S. Line

Ft. from E. Line

330 Ft. from W. Line

Location

Rig up

Drilling and Remarks:

P B 3365201 oil
37 water

RECORD

Cased in., ft.Sand Sil 3324Gas Oil Total Depth 3400

PRODUCTION

1st 24 hrs. Nat. 1st 24 hrs. after shot Gas Cu. Ft.Dry Hole Abandoned

Date

9-25-35 192

ORVAL MANNSCHECK

Scout