

KANSAS

Barton


FORM 51 5M 10-41 PETROL

Section 20 Township 20 Range 11-W

Well No. 3 Grant

Company Champlin

NORTH Silica pool

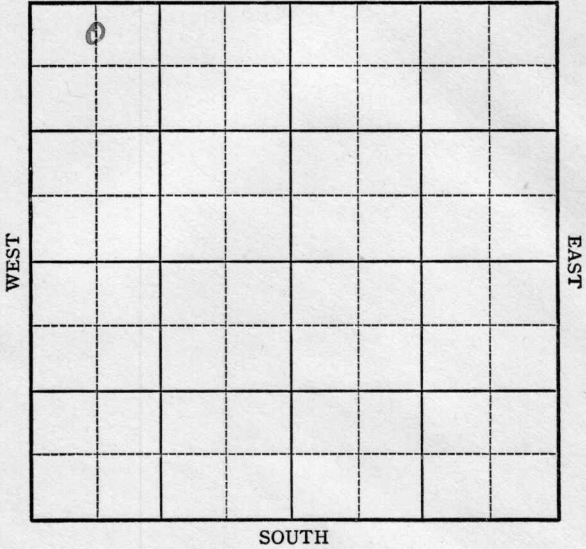

Sec. 20 Twp. 20 R. 11-W

Well No. #3 Grant Farm

Champlin Company


(Silica)

330 Ft. from N. Line

_____ Ft. from S. Line

_____ Ft. from E. Line

660 Ft. from W. Line

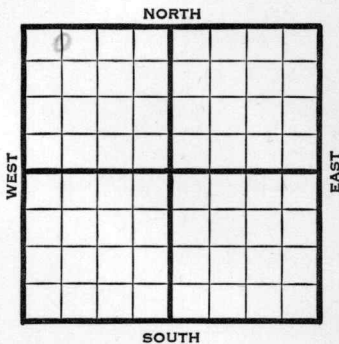

1941	REPORT
12/3	8" - 253'
	Drlg. 2360'
12/11	Art. 3297 TD 3311- 4" @ 3297
	RUST
12/18	Swb. 25 oil per hr. 2000 acid
12/24	Potential 65 bbls., pump.
12/31	" " " "
1942	
1/8	" " " "
1/14	Arb. 3297'
	4" - 3297'
	T.D. 3311'
	2000 acid.
	Potential 65 bbls., pump.
	43. Gravity
	COMPLETED

Barton

KANSAS

Map No. 46 Sec. 20 Twp. 20 R. 11W

Well No. 3 Grant

Champlin Company

~~FIRST REPORT~~ Contractor

C N $\frac{1}{2}$ NW NW

SECTION PLAT

330 Ft. from N. Line

0			

_____ Ft. from S. Line

_____ Ft. from E. Line

660 Ft. from W. Line

SILICA POOL

Location _____

Rig up _____

Drilling and Remarks:

8" - 253'

Drlg. 2360'

RECORD

Cased _____ in., _____ ft.

Sand _____

Gas _____

Oil _____

Total Depth _____

PRODUCTION

1st 24 hrs. Nat. _____

1st 24 hrs. after shot _____

Gas _____ Cu. Ft.

Dry Hole _____

Abandoned _____

Date

DEC 3 1941 19

S. J. LEWIS Scout

Map No. 46 Sec. 20 Twp. 20 R. 11W

Well No. 3 Grant

Champlin Company

COMPLETED Contractor

C N $\frac{1}{2}$ NW NW

SECTION PLAT

330 Ft. from N. Line

D			

_____ Ft. from S. Line

_____ Ft. from E. Line

660 Ft. from W. Line

SILICA POOL

Location _____

Rig up _____

Drilling and Remarks:

cu x 3297
4" @ 3297
2000 acid
Pump 65 P.S.

43^e yr

RECORD

Cased _____ in., _____ ft.

Sand _____

Gas _____

Oil _____

Total Depth 3311

PRODUCTION

1st 24 hrs. Nat. _____

1st 24 hrs. after shot _____

Gas _____ Cu. Ft.

Dry Hole _____

Abandoned _____

Date

JAN 14 1942 19

S. J. LEWIS Scout