


Section 21 Township 20 Range 11W

Well No. #2 Hagen

Company F. G. Holl

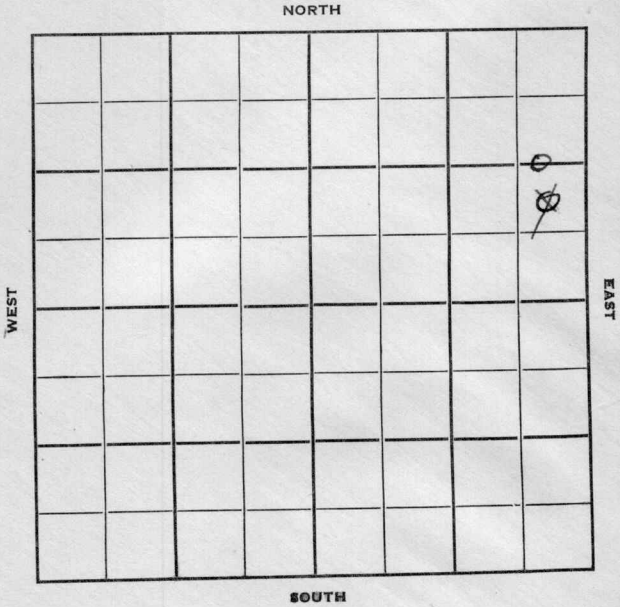

Barton

KANSAS

Sec. 21 Twp. 20 R. ✓ 11W

Well No. #2 Hagen Farm

F. G. Holl Company

Atlas -Contr. Contractor

Chase Pool


Ft. from N. Line

1320
990 Ft. from S. Line

450
330 Ft. from E. Line

Ft. from W. Line

CEX E 2 NE
NE SE NE

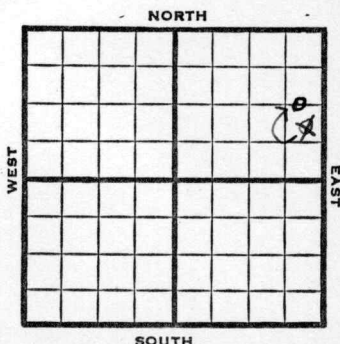

1951

REPORT

10/24

Spud 10-19-51
8" @ 259
Anhy 515
Drlg. 1726'

11/14

Spud 10-19-51
D&A TD 3365
8" @ 259'
Anhy 515 Top. 2642
Heeb. 2911 Tor. 2927
Br. Lime 3034 Lans. 3053
DST 3136-46 open 45 min.
Rec. 510' oily sw
Arb. 3307 TD 3309
5" @ 3308 DD 3365 4 BWPH
BB ? Perf/ 3190-3210
D&A

ABANDONED

County **Barton** State **Kansas**
Sec. **21** (Blk.) **20** (Sur.) **11W** Map No.
Operator **F. G. Holl**
Well No. **2** Farm **Hagen**
Elev. Location **NE SE NE**

FIRST REPORT

990 Ft. From **S** Line **NE**
330 Ft. From **E** Line Quarter
1st. Report **OCT 24 1951**
Completion
Remarks
Atlas - Contr.
Spudding Date **10-19-51**


Drlg. Data **Chase Pool**
8" @ 259 Anhy 515 drlg. 1726

Map No. _____ Sec. 21 Twp. 20 R. 11WWell No. 2 HagenF. G. Holl Company**CORRECTION**

Contractor

C E L E $\frac{1}{2}$ NE

SECTION PLAT

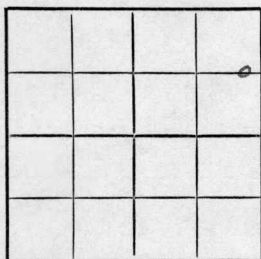

_____ Ft. from N. Line

1320 Ft. from S. Line450 Ft. from E. Line

_____ Ft. from W. Line

Barton County

RECORD

Location _____

Cased _____ in., _____ ft.

Rig up _____

Sand _____

Drilling and Remarks:

Gas _____

Oil _____

Total Depth _____

Reported

NE SE NE

PRODUCTION

1st 24 hrs. Nat. _____

1st 24 hrs. after shot _____

Gas _____ Cu. Ft.

Dry Hole _____

Abandoned _____

Date

OCT 31 1951

19

J. E. TYRA


Scout

County Barton State Kansas
 Sec. 21 (Blk.) 20 (Sur.) 11W Map No.

Operator F. G. Holl

Well No. 2 Farm Hagen

Elev. 1768 Location C E L E $\frac{1}{2}$ NE

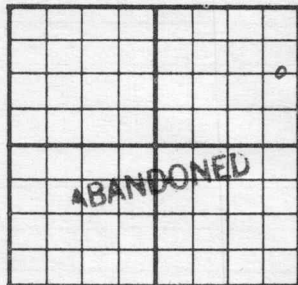

1320 Ft. From S Line NE

450 Ft. From E Line Quarter

1st. Report

Completion NOV 14 1951

Remarks Chase Pool

Atlas - Contr.

Spudding Date 10-19-51

Drlg. Data D & A TD 3365

8" @ 259 Anhy 515 Top. 2642

Heeb. 2911 Tor. 2927 Br. lime 3034

Lams. 3053 DST 3136-46 open 45 min.

Rec. 510' oily sw Arb. 3307 TD 3309

5" @ 3308 DD 3365 4 bwph PB ?

Perf/ 3190-3210

D & A

J. E. TYRA