

# KANSAS

Form 51—5M—7-39—Palace

Barton

Section 21 Township 20 Range 11-W

Well No. #1 Meggers


Company Duwe & Harris et al

Hagen Pool

NORTH

WEST

EAST

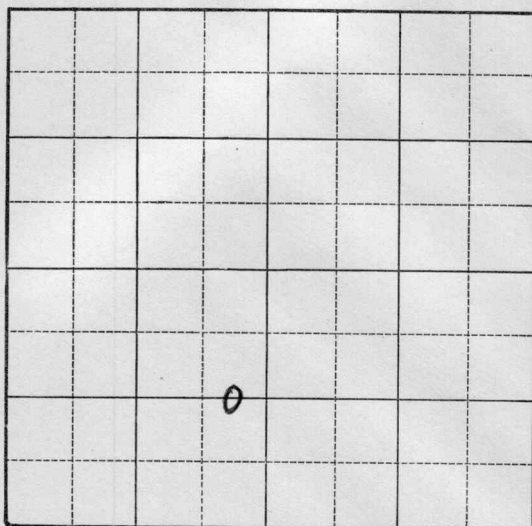

SOUTH



Barton

KANSAS

Map No. 46 Sec. 21 Twp. 20 R. 11WWell No. 1 MeggersDuwe & Farris etal

Company

Contractor

## FIRST REPORT

C E L SW


\_\_\_\_\_ Ft. from N. Line

1320 Ft. from S. Line330 Ft. from E. Line

\_\_\_\_\_ Ft. from W. Line

HAGEN POOL

## SECTION PLAT

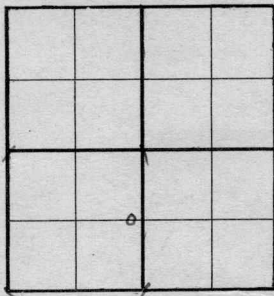

Location \_\_\_\_\_

Rig up \_\_\_\_\_

Drilling and Remarks:

Rotary

## RECORD

Cased \_\_\_\_\_ in., \_\_\_\_\_ ft.

Sand \_\_\_\_\_

Gas \_\_\_\_\_

Oil \_\_\_\_\_

Total Depth \_\_\_\_\_

## PRODUCTION

1st 24 hrs. Nat. \_\_\_\_\_

1st 24 hrs. after shot \_\_\_\_\_

Gas \_\_\_\_\_ Cu. Ft.

Dry Hole \_\_\_\_\_

Abandoned \_\_\_\_\_

Date

NOV 22 1939

19

S. J. LEWIS

Scout


Map No. 46 Sec. 21 Twp. 20 R. 11WWell No. 1 MeggersDuwe & Farris etal Company

Contractor

ABANDONED

C E L SW

## SECTION PLAT

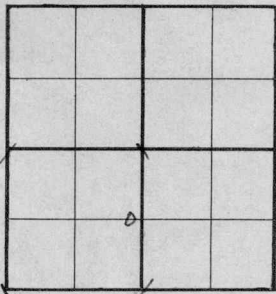

Ft. from N. Line

1320 Ft. from S. Line330 Ft. from E. Line

Ft. from W. Line

HAGEN POOL

Location \_\_\_\_\_

Rig up \_\_\_\_\_

Drilling and Remarks:

*Per 3339**No shovels*

## RECORD

Cased \_\_\_\_\_ in., \_\_\_\_\_ ft.

Sand \_\_\_\_\_

Gas \_\_\_\_\_

Oil \_\_\_\_\_

Total Depth 3352

## PRODUCTION

1st 24 hrs. Nat. \_\_\_\_\_

1st 24 hrs. after shot \_\_\_\_\_

Gas \_\_\_\_\_ Cu. Ft.

Dry Hole \_\_\_\_\_

Abandoned \_\_\_\_\_

Date

JAN 3 1940

19

S. J. LEWIS

Scout