

KANSAS


Rice

Section 27 Township 18 Range 9W

Well No. #1 Volkland

Company B & R Drlg.

Volkland Pool NORTH

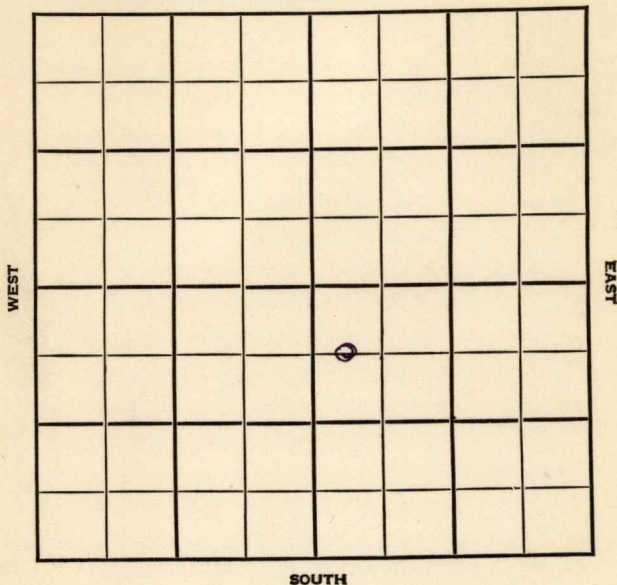

KANSAS

Rice

Sec. 27 Twp. 18 R. 9W

Well No. #1 Volkand Farm

B & R Drlg.

Company

Volkland Pool


660' Ft. from N. Line

Ft. from S. Line

Ft. from E. Line

330' Ft. from W. Line

C W L NW SE

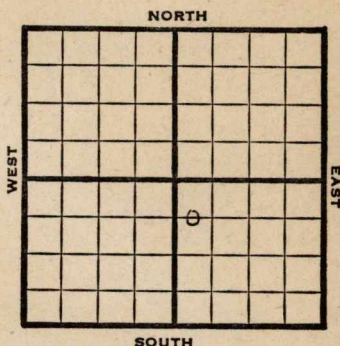

1948

Elev. 1723'

REPORT

3/31 Surface Hole

4/7 8" @ 172'

Lansing 2872'

Drlg. 3010'

4/14 Arbuckle 3246'

TD 3251'

5" @ 3246'

RUST

4/21 PB 3250'

4/28 PB 3244½'

5/5 Arbuckle 3246'

5" @ 3246

TD 3268'

ABANDONED

Map No. _____ Sec. 27 Twp. 18 R. 9W

Well No. 1 Volkland


B & R Drlg. Company

FIRST REPORT

Contractor

C W L NW SE

SECTION PLAT

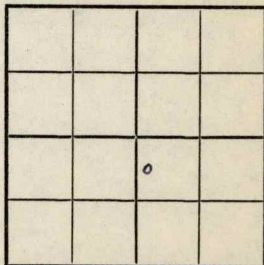

660 Ft. from N. Line

_____ Ft. from S. Line

_____ Ft. from E. Line

330 Ft. from W. Line

Rice County

Location _____

Rig up _____

Drilling and Remarks:

surface hole

RECORD

Cased _____ in., _____ ft.

Sand _____

Gas _____

Oil _____

Total Depth _____

PRODUCTION

1st 24 hrs. Nat. _____

1st 24 hrs. after shot _____

Gas _____ Cu. Ft.

Dry Hole _____

Abandoned _____

Date

MAR 31 1948

19

S. J. LEWIS

Scout

Map No. 45 Sec. 27 Twp. 18 R. 9WWell No. 1 Volkland


B & R Drlg.

Company

ABANDONED

Contractor

C W L NW SE

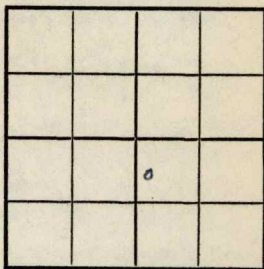E11783
SECTION PLAT660 Ft. from N. Line Ft. from S. Line Ft. from E. Line330 Ft. from W. LineRice CountyLocation Rig up

Drilling and Remarks:

*Cr 83246**5" 83246*

RECORD

Cased in., ft.Sand Gas Oil Total Depth 8265

PRODUCTION

1st 24 hrs. Nat. 1st 24 hrs. after shot Gas Cu. Ft.Dry Hole Abandoned

Date

MAY 5 1948

19

S. J. LEWIS

Scout