


Section 2 Township 20 Range 11-W

Well No. #3 Hagan

Company Broderick & Gordon  
Hagan

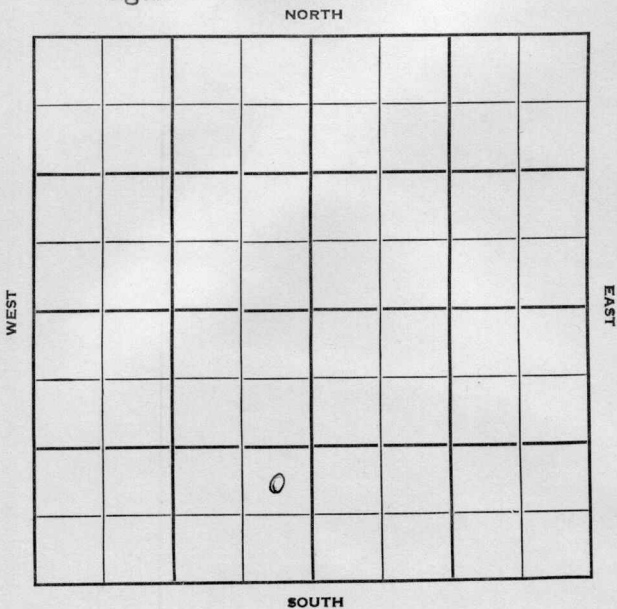

Sec. 20 Twp. \_\_\_\_\_ R. \_\_\_\_\_

Well No. #3 Hagen Farm \_\_\_\_\_

Broderick & Gordon Company \_\_\_\_\_

Contractor \_\_\_\_\_

Hagan Pool


\_\_\_\_\_ Ft. from N. Line

990' Ft. from S. Line

330' Ft. from E. Line

\_\_\_\_\_ Ft. from W. Line

NE SE SW

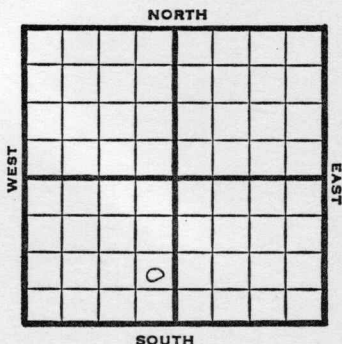

1950

Elev 1795'

REPORT

3/8

Spud 3-5-50  
8" @ 263'  
Anhy 550-70  
Drlg. 716'

4/5

TD 3270'  
8" @ 263  
Arb. 3252'  
5" @ 3567'  
Lost circulation  
complete for salt wtr disposal  
Comp

**COMPLETED**

Kansas

Hagan Pool

Map No. \_\_\_\_\_ Sec. 20 Twp. 20 R. 11W

Well No. 3 Hagan

Broderick & Gordon Company

Contractor

NE SE SW

SECTION PLAT

	0		

FIRST REPORT

\_\_\_\_\_ Ft. from N. Line

990 Ft. from S. Line

330 Ft. from E. Line

\_\_\_\_\_ Ft. from W. Line

Barton County

Location \_\_\_\_\_

Rig up \_\_\_\_\_

Drilling and Remarks:

Spud 3-5-50

8" @ 263

Anhy 550-70

dflg. 716

RECORD

Cased \_\_\_\_\_ in., \_\_\_\_\_ ft.

Sand \_\_\_\_\_

Gas \_\_\_\_\_

Oil \_\_\_\_\_

Total Depth \_\_\_\_\_

PRODUCTION

1st 24 hrs. Nat. \_\_\_\_\_

1st 24 hrs. after shot \_\_\_\_\_

Gas \_\_\_\_\_ Cu. Ft.

Dry Hole \_\_\_\_\_

Abandoned \_\_\_\_\_

Date

MAR 8 1950 19

J. E. TYRA

Scout

Kansas

Hagan Pool

Map No. \_\_\_\_\_ Sec. 20 Twp. 20 R. 11W

Well No. 3 Hagan

Broderick & Gordon Company

Contractor

NE SE SW

E/ 1795  
SECTION PLAT

\_\_\_\_\_ Ft. from N. Line

990 Ft. from S. Line

330 Ft. from E. Line

\_\_\_\_\_ Ft. from W. Line

COMPLETE			
	o		

Barton County

Location \_\_\_\_\_

Rig up \_\_\_\_\_

Drilling and Remarks:

8" @ 263

Ant-3252

5" @ 3567

Last Circulation

complete for

Salt Water Disposal

RECORD

Cased \_\_\_\_\_ in., \_\_\_\_\_ ft.

Sand \_\_\_\_\_

Gas \_\_\_\_\_

Oil \_\_\_\_\_

Total Depth 3270

PRODUCTION

1st 24 hrs. Nat. \_\_\_\_\_

1st 24 hrs. after shot \_\_\_\_\_

Gas \_\_\_\_\_ Cu. Ft.

Dry Hole \_\_\_\_\_

Abandoned \_\_\_\_\_

Date

APR 5 1950

19

J. E. TYRA

Scout