

KANSAS


FORM 51 5M PETROL

Rice

Section 27 Township 18 Range 9 W

Well No #1 Sangster

Company Texas

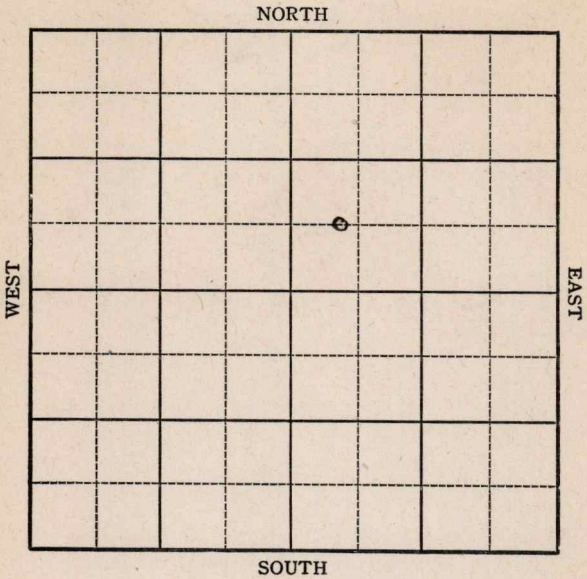

KANSAS


Rice

Sec. 27 Twp. 18 R. 9-W

Well No. #1 Sangster Farm

Texas Company

NORTH

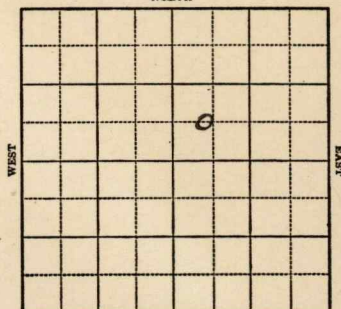

SOUTH

 Ft. from N. Line

660 Ft. from S. Line

 Ft. from E. Line

510 Ft. from W. Line

1943

Elev. 1727 REPORT

12/1 Location.

12/8 8" @ 246

Drlg. 1320'

12-15 Drlg. 2968'

12/22 Arb 3256-64 TD

5" @ 3257

Rust

12/29 1000' in 2 hrs

1944

1-5 SD

1-12 "

1/19 5" @ 3257

Arb 3256

TD 3264'

Pump 432 Pot. & 32% water

Gravity 42


COMPLETED

KANSASMap No. 45 Sec. 27 Twp. 18 R. 9WWell No. 1 SangsterTexas

Company _____

FIRST REPORT

Contractor _____

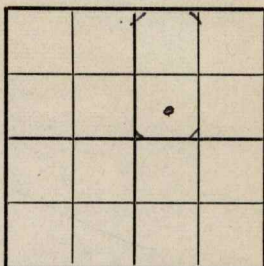C SW NE**SECTION PLAT**

_____ Ft. from N. Line

660 Ft. from S. Line

_____ Ft. from E. Line

510 Ft. from W. Line**Volkland Pool**Location S

Rig up _____

Drilling and Remarks: _____

RECORD

Cased _____ in., _____ ft.

Sand _____

Gas _____

Oil _____

Total Depth _____

PRODUCTION

1st 24 hrs. Nat. _____

1st 24 hrs. after shot _____

Gas _____ Cu. Ft.

Dry Hole _____

Abandoned _____

Date

DEC 1 1943 19S. J. LEWIS Scout


KANSASMap No. 45 Sec. 27 Twp. 18 R. 9WWell No. 1 SangsterTexas

Company

COMPLETED

Contractor

C SW NE

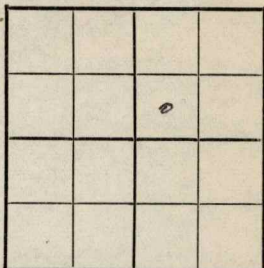SECTION PLAT

Ft. from N. Line

660

Ft. from S. Line

Ft. from E. Line

510

Ft. from W. Line

Volkland Pool

Location

Rig up

Drilling and Remarks:

*See 43256**5" 43257**Pump 43257**+32% Water**42 2/3***RECORD**

Cased _____ in., _____ ft.

Sand _____

Gas _____

Oil _____

Total Depth 3264**PRODUCTION**

1st 24 hrs. Nat. _____

1st 24 hrs. after shot _____

Gas _____ Cu. Ft.

Dry Hole _____

Abandoned _____

Date

JAN 19 1944 19**S. J. LEWIS**

Scout