


KANSAS

Barton

Section 20 Township 20 Range 11WWell No. 1 HagerCompany Pickrell & HollSilica
NORTH

WEST

EAST

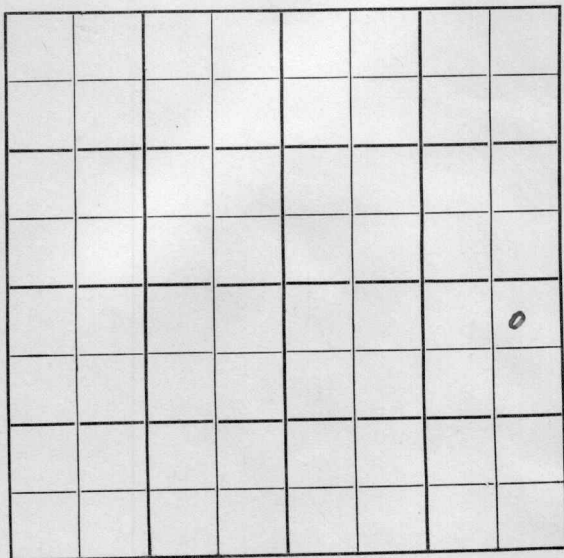

SOUTH

Barton KANSAS

Sec. 20 Twp. 20 R. 11W

Well No. #1 Hager Farm


Pickrell & Holl Company
Silica Pool (Pickrell, Cont.)

330' Ft. from N. Line

Ft. from S. Line

330' Ft. from E. Line

Ft. from W. Line

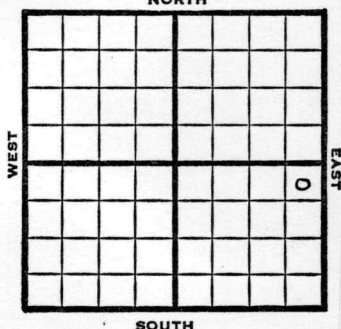

NE SE

SOUTH

1949

Elev 1778'

REPORT

10/19

Surface Hole

10/26

" "

11/2

TD 3371 In Cong.

Lansing 3081'

Cong 3357'

Aband.

ABANDONED

Map No. _____ Sec. 20 Twp. 20 R. 11W

Well No. 1 Hager

Pickrell & Holl Company

Pickrell Contractor

NE SE


FIRST REPORT
SECTION PLAT

330 Ft. from N. Line

_____ Ft. from S. Line

330 Ft. from E. Line

_____ Ft. from W. Line

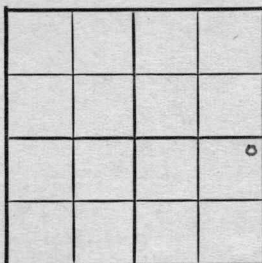

Barton County

Location _____

Rig up _____

Drilling and Remarks:

surface hole

RECORD

Cased _____ in., _____ ft.

Sand _____

Gas _____

Oil _____

Total Depth _____

PRODUCTION

1st 24 hrs. Nat. _____

1st 24 hrs. after shot _____

Gas _____ Cu. Ft.

Dry Hole _____

Abandoned _____

Date

OCT 19 1949

19

S. J. LEWIS

Scout

Kansas

Silica Pool

Map No. _____ Sec. 20 Twp. 20 R. 11WWell No. 1 Hager

Pickrell & Holl

Company

ABANDONED

Contractor


NE SE

2/1/1978
SECTION PLAT330 Ft. from N. Line

_____ Ft. from S. Line

330 Ft. from E. Line

_____ Ft. from W. Line

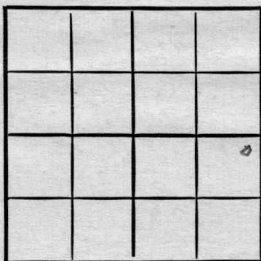

Barton County

Location _____

Rig up _____

Drilling and Remarks:

*Leaves 3087**Crang 3357*

RECORD

Cased _____ in., _____ ft.

Sand _____

Gas _____

Oil _____

Total Depth 3371 in Crang

PRODUCTION

1st 24 hrs. Nat. _____

1st 24 hrs. after shot _____

Gas _____ Cu. Ft.

Dry Hole _____

Abandoned _____

Date

NOV 2 1949

19

S. J. LEWIS

Scout