


Section 22 Township 20 Range 11 W

Well No. # 5 Donnebohm

Company W. L. Hartman

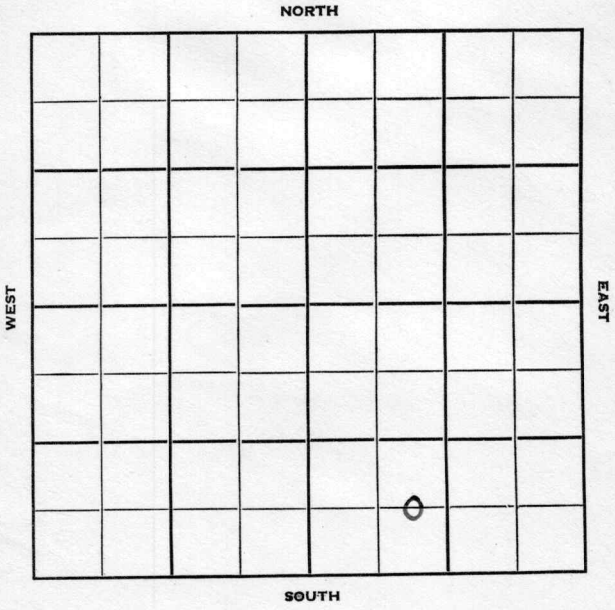

Sec. 22 Twp. 20 R. 11 W

Well No. # 5 Donnebohm Farm

W. L. Hartman Company

Hartman Contractor


Ft. from N. Line

660 Ft. from S. Line

Ft. from E. Line

990 Ft. from W. Line

C E/2 SW SE

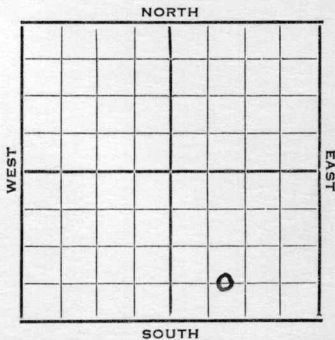

1952 Elev. 1762' REPORT

4/9 Spud 3-31-52
10" @ 158'
Topeka 2636'
Drlg. 2714'

4/23 Lans. 3043 RTD 3048
7" @ 3048 DP CO 3048 NS
DD 2067 TD NS

4/30 NR

5/7 DD 3190'

5/14 NR

5/21 Spud 3-31-52
Oil well TD 3190' 10" @ 158'
Top. 2636' Lans. 3043'
TD 3048' 7" @ 3048 CO to 3048
DD 3067' DD 3190'
Comp. BHB 850 BOPD

COMPLETED

County Barton State Kansas

Sec. 22 (Blk. 20 (Sur. 11W (Twp. 20 (Rge. 11W Map No.

Operator W. L. Hartman

Well No. 5 Farm Donnebohm

Elev. 1762 Location C E L SW SE

COMPLETE

660 Ft. From S Line SE

990 Ft. From W Line Quarter

Ist. Report

Completion MAY 21 1952

Remarks

Hartman - Contr.

Spudding Date 3-31-52

Drlg. Data Oil well TD 3190

10" @ 158 Top. 2636 Lans. 3043

TD 3048 7" @ 3048 CO to 3048 DD 3067

DD 3190 Comp. BHB 850 bopd