


Rice county

Section 28 Township 18 Range 9-W

Well No. #1, Chase

Company Phil-Han

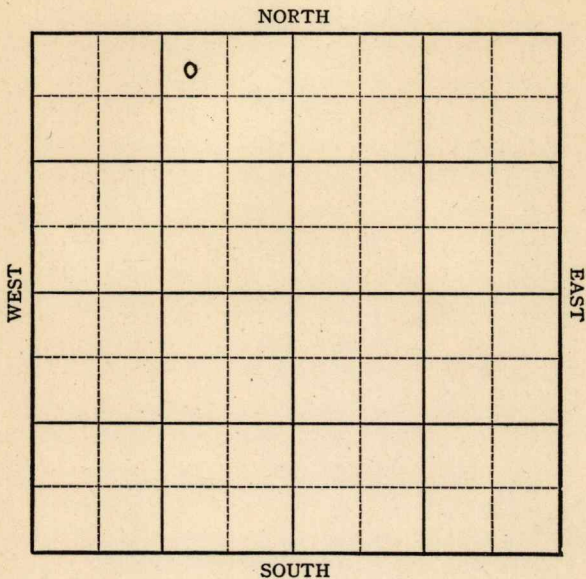

KANSAS

Rice County ✓

Sec. 28 Twp. 18 R. 9W

Well No. #1 Chase Farm _____

Phil-Han Company _____

Wildcat


330 Ft. from N. Line

_____ Ft. from S. Line

990 Ft. from E. Line

_____ Ft. from W. Line

NW NE NW

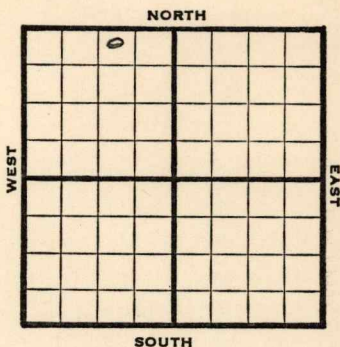

1946

1720

REPORT

9/11 RUR

9/18 8" @ 289'

Anhy 412'

Drlg 1010'

9/24 Drlg 3108'

10/1 **Lans 2886'**

Arb 3249

TD 3250'

5" @ 3349 swb 10 oil PH

10/8 " " "

10/15 " " "

10/23 **Arb 3249'**

5" @ 3249'

250 Acid

TD 3255'

Pump 100 oil plus 100 w POT

Grav. 41

COMPLETED

Kansas Pool Name WildcatMap No. 45 Sec. 28 Twp. 18 R. 9WWell No. 1 ChasePhil-Han Company

FIRST REPORT

Contractor

NW NE NW

SECTION PLAT

330 Ft. from N. Line

Ft. from S. Line

990 Ft. from E. Line

Ft. from W. Line

	0		

Rice County

Location

Rig up

Drilling and Remarks:

R U R

RECORD

Cased _____ in., _____ ft.

Sand _____

Gas _____

Oil _____

Total Depth _____

PRODUCTION

1st 24 hrs. Nat. _____

1st 24 hrs. after shot _____

Gas _____ Cu. Ft.

Dry Hole _____

Abandoned _____

Date


SEP 11 1946 19S. J. LEWIS Scout

KANSAS
KansasMap No. 45 Sec. 28 Twp. 18 R. 9WWell No. 1 ChasePhil-Han Company

COMPLETED

Contractor

NW NE NW

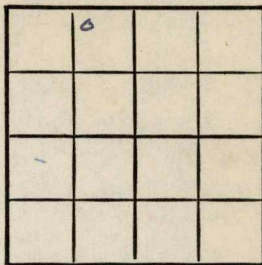E 11720
SECTION PLAT330 Ft. from N. Line Ft. from S. Line990 Ft. from E. Line Ft. from W. Line

Rice County

Location Rig up

Drilling and Remarks:

Cr 3249
5" @ 3249
200 acid
Pump 100 oil +
100 W P &

412-92

RECORD

Cased in., ft.Sand Gas Oil Total Depth 3255

PRODUCTION

1st 24 hrs. Nat. 1st 24 hrs. after shot Gas Cu. Ft.Dry Hole Abandoned

Date

OCT 23 1946 19

S. J. LEWIS Scout