

KANSAS


FORM 51 5M BRIX

Barton County

Section 22 Township 20 Range 11W

Well No. #1 C. Kasselmann

Company Continental

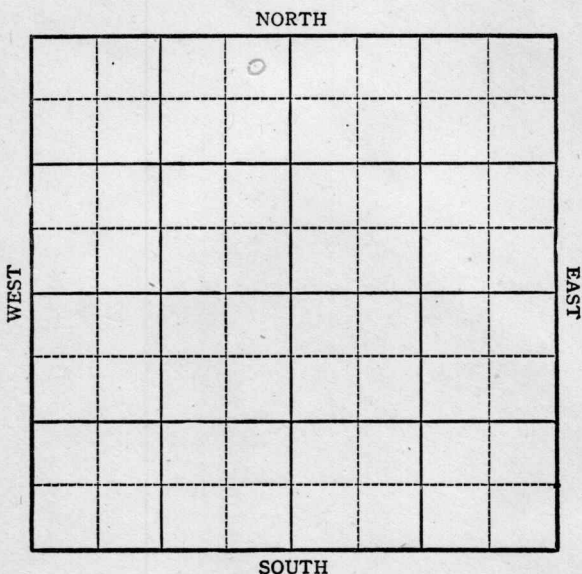

Barton Co.

Silica

Sec. 22 Twp. 20 R. 11W

Well No. 1 C Kasselmann Farm

Continental Company

NE NW


330 Ft. from N. Line

 Ft. from S. Line

330 Ft. from E. Line

 Ft. from W. Line

Elev. 1767

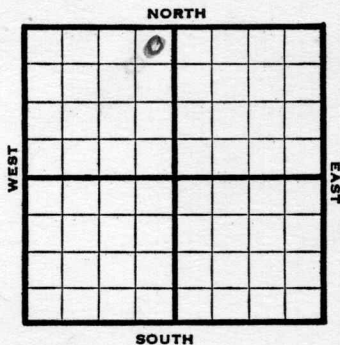

1944

REPORT

9-13

Location

9/21

Drk.

9/28

Drlg. 140

10/4

13" @ 230

Drlg. 1900

10/11

Drlg. 22940

10/18

Lans 3070

Arb 3317

TD 3368

ABANDONED

KANSAS


Pool Name SiliceMap No. 46 Sec. 22 Twp. 20 R. 11WWell No. 1 C. KasselmanContinental Company

FIRST REPORT

Contractor

NE NW

SECTION PLAT

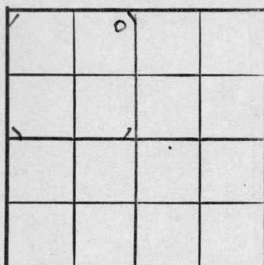330 Ft. from N. Line Ft. from S. Line330 Ft. from E. Line Ft. from W. Line

Barton

Location XRig up

Drilling and Remarks:

RECORD

Cased in., ft.Sand Gas Oil Total Depth

PRODUCTION

1st 24 hrs. Nat. 1st 24 hrs. after shot Gas Cu. Ft.Dry Hole Abandoned

Date

SEP 13 1944 19S. J. LEWIS Scout

Pool Name SilicaMap No. 46 KANSAS Sec. 22 Twp. 20 R. 11WWell No. 1 C. KasselmanContinental

Company

ABANDONED

Contractor

NE NW


SECTION PLAT

330 Ft. from N. Line

Ft. from S. Line

330 Ft. from E. Line

Ft. from W. Line

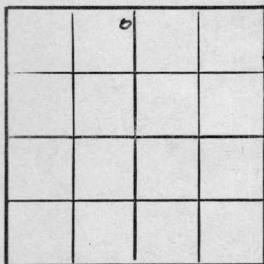Barton

Location

Rig up

Drilling and Remarks:

Lease 3070Ac 43317

RECORD

Cased _____ in., _____ ft.

Sand _____

Gas _____

Oil _____

Total Depth 3365

PRODUCTION

1st 24 hrs. Nat. _____

1st 24 hrs. after shot _____

Gas _____ Cu. Ft.

Dry Hole _____

Abandoned _____

Date

OCT 1 8 1944

19

S. J. LEWIS

Scout