


Section 22 Township 20 Range 11W

Well No. #1 Kastleman

Company F. G. Holl

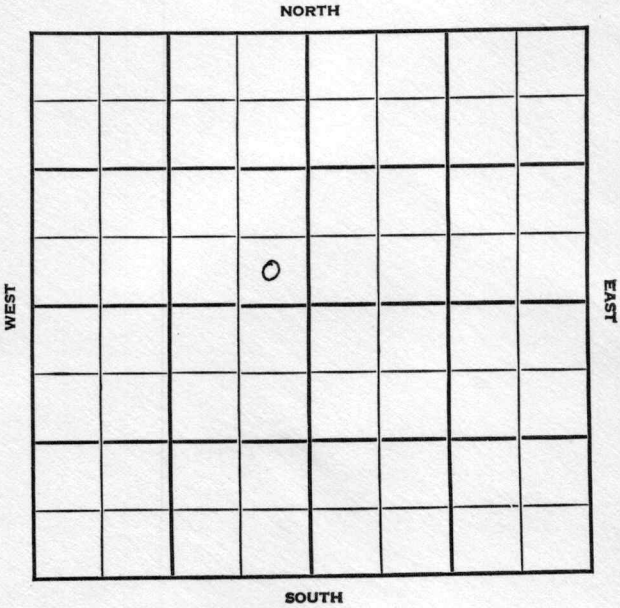

Sec. 22 Twp. 20 R. 11W

Well No. #1 Kasselman Farm

F. G. Holl Company


Silica

 Ft. from N. Line

330 Ft. from S. Line

330 Ft. from E. Line

 Ft. from W. Line

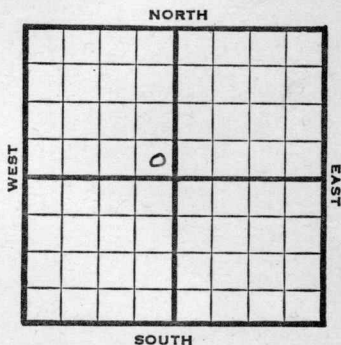

SE NW

1947

REPORT

12/30

8" @ 300'
 Broun Lime 3033'
 Lans. 3051'
 B. K. C. 3278'
 Cong. 3307'
 Re Arb. 3316'
 Arb. 3320-47' TD
 TD 3347'
 D&A

FIRST REPORT

~~ABANDONED~~

Map No. 46 Sec. 22 Twp. 20 R. 11W

Well No. 1 Kasselman

F. G. Holl Company

FIRST REPORT Contractor

SE NW

ABANDONED

SECTION PLAT

 Ft. from N. Line

330 Ft. from S. Line

330 Ft. from E. Line

 Ft. from W. Line

| | | | |
|--|--|--|--|
| | | | |
| | | | |
| | | | |
| | | | |
| | | | |

Barton County

Location

Rig up

Drilling and Remarks:

8" @ 300

Br. lime 3033

Lans, 3051

B KC 3278

Cong. 3307

Re Arb. 3316

Arb. 3320-47 TD

D & A

RECORD

Cased in., ft.

Sand

Gas

Oil

Total Depth 2347

PRODUCTION

1st 24 hrs. Nat.

1st 24 hrs. after shot

Gas Cu. Ft.

Dry Hole

Abandoned

Date

DEC 30 1947 19

S. J. LEWIS

Scout