Form 51-5M 5-37 Petrol


Barton

KANSAS

Section 23 Township 20 Range 11-W

Well No. #1 Bryant

Company Lario & Atlantic

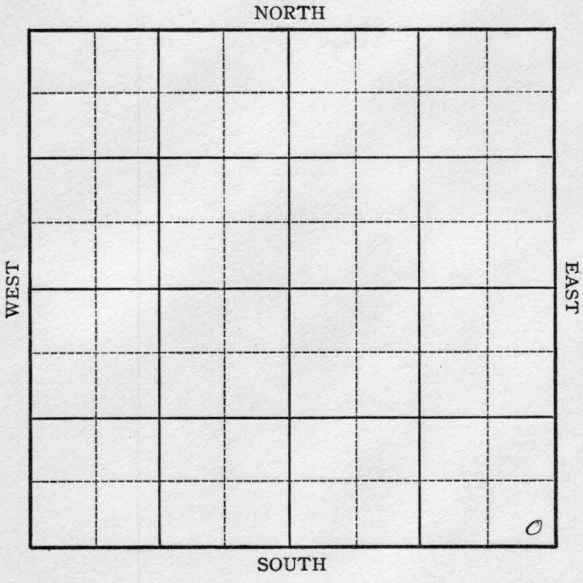


Form 252-A—5M—2-37—Palace KANSAS Barton

Sec. 23 Twp. 20 R. 11-W

Well No. #1 Bryant Farm

Lario & Atlantic Company

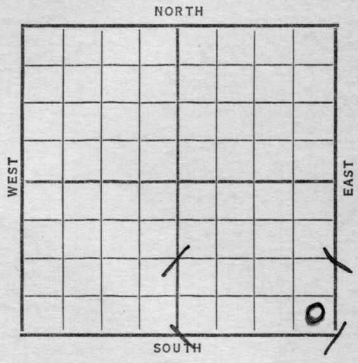

_____ Ft. from N. Line

330 Ft. from S. Line

330 Ft. from E. Line

_____ Ft. from W. Line

Elev. 1755

Date	REPORT
1937	
9/29	Mat'l.
10/8	R. R.
10/15	"
10/22	12" @ 178'. Drlg. 1350'.
10/29	Drlg. 2710'.
11/5	Sil. 3257& & 7". T.D. 3260'.
	Sat. core. RUST.
11/10	8" @ 3257'.
	Sil. 3257'.
	T.D. 3265'.
	Potential 2284 bbls., Nat.
	COMPLETED

Form 26—1M Bks.—2-29 Barton KANSAS

Map No. Sec. 23 Twp. 20 R. 11W

Well No. 1-Bryant

Lario & Atlantic Company

Contractor

FIRST REPORT

SE / C


Ft. from N. Line

330 Ft. from S. Line

330 Ft. from E. Line

Ft. from W. Line

SECTION PLAT

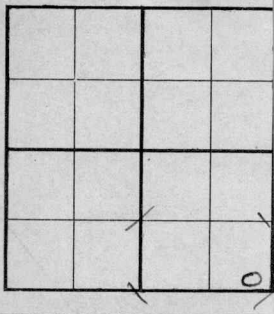

Location

Rig up

Drilling and Remarks:

Matl.

RECORD

Cased in., ft.

Sand

Gas

Oil

Total Depth

PRODUCTION

1st 24 hrs. Nat.

1st 24 hrs. after shot

Gas Cu. Ft.

Dry Hole

Abandoned

Date

SEP 29 1937 19

H. D. Hatfield Scout

Form 26—1M Bks.—2-29

Barton KANSAS

Map No. _____ Sec. 23 Twp. 20 R. 11W

Well No. 1 Bryant

Lario & Atlantic Company

Contractor

COMPLETED

SE/C


_____ Ft. from N. Line

330 Ft. from S. Line

330 Ft. from E. Line

_____ Ft. from W. Line

SECTION PLAT

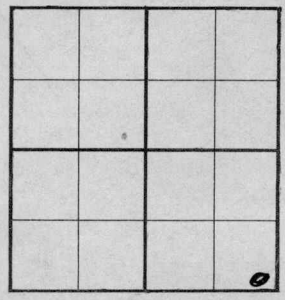

Location _____

Rig up _____

Drilling and Remarks:

Pot - 2284

Nat,

RECORD

Cased 8 in., 3257 ft.

~~Sand~~ Sil 3257

Gas _____

Oil _____

Total Depth 3265

PRODUCTION

1st 24 hrs. Nat. _____

1st 24 hrs. after shot _____

Gas _____ Cu. Ft.

Dry Hole _____

Abandoned _____

Date

NOV 10 1937 19 ____ H. D. Hatfield Scout