

Section 30 Township 18 Range 2W


Well No. #5 Johnson

Company Lawrence & Bush

NORTH

WEST

EAST

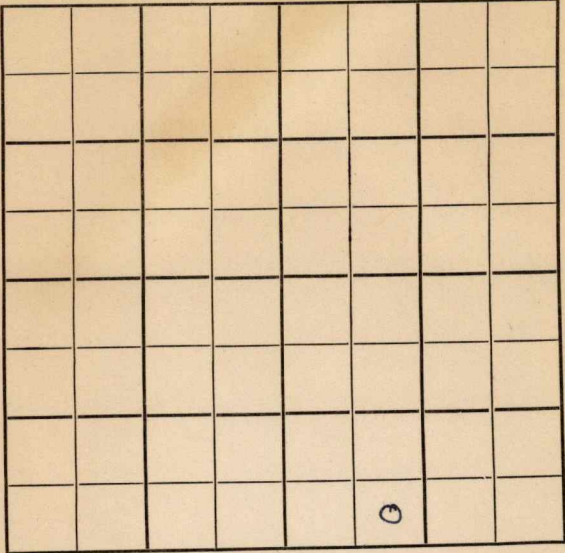

SOUTH

15

3

McPherson

KANSAS


Sec. 30 Twp. 18 R. 2W

Well No. #5 Johnson Farm

Lawrence & Bush Company

Contractor

Ft. from N. Line  
330  
Ft. from S. Line  
Ft. from E. Line  
990  
Ft. from W. Line  
**SE SW SE**

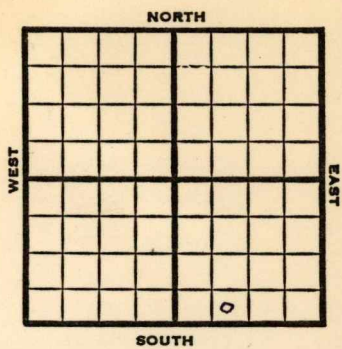

1952 **Elev. 1553'** REPORT

10/8 Cellar & Pits

10/15 10" @ 95  
Drlg. 1000'

10/22 NR

10/29 **KC 2305'** RTD 2308' ~~XXXXXX~~  
5" @ 2300' CO & POP

11/5 Spud 10-13-52  
Oil Well TD 2319' 10" @ 95'  
**KC 2305** TD 2308 5" @ 2300  
DD 2319 3000 A S/ 63 bo 3 hr.  
Comp. 40 bopd

**COMPLETED**



