

Form 51-5M-5-34-Palace

Map No. 1 Sec. 20 Twp. 10 R. 7

Well No. 25 Lumberg Farm

Company

NORTH

WEST

0

EAST

SOUTH

Location _____

Drilling Remarks

Rig Up

Drilling Remarks

RECORD

Cased_____in. _____ft.

Sand.....

Gas

Oil_____

Total Depth

PRODUCTION

1st 24 hrs. Nat. _____

1st 24 hrs. after shot_____


Gas _____ cu. ft.

Dry Hole.....

Abandoned

Elev. 1554

NORTH

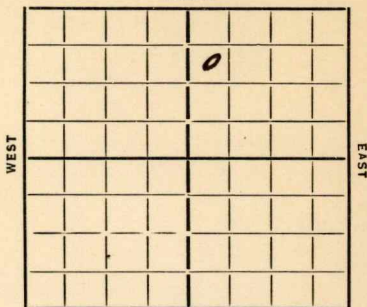

SOUTH

Date 1935

REPORT

1122
5/2/2 Location

5/29 — 6/6 —

6/3	King
-----	------

6/20 15" 100 12" 350

6/28 Aug 1070

17/30

15" 8" 18 19 14 11 2 1 3 8

11/11	0 1067	HF00	2150
	1" 5161	60	5161

6 2181 allg 2183

7/18 K 2200 ✓ 5" 2203

1, T2 2288 woc

7/24 K @ 2280

7 T 2 2311

3 & 5 Water

COMPLETED

Map No. 42 Sec. 30 Twp. 18 R. 2 W

Well No. 3-Lumberg

Palmer Company

Contractor

FIRST REPORTS

SECTION PLAT

990 Ft. from N. Line

_____ Ft. from S. Line

_____ Ft. from E. Line

330 Ft. from W. Line

		0	

Location ✓

Rig up _____

Drilling and Remarks:

RECORD

Cased _____ in., _____ ft.

Sand _____

Gas _____

Oil _____

Total Depth _____

PRODUCTION

1st 24 hrs. Nat. _____

1st 24 hrs. after shot _____

Gas _____ Cu. Ft.

Dry Hole _____

Abandoned _____

Date

5-22-35 192

ORVAL MANSCHRECK Scout

KANSAS

Map No. 42 Sec. 30 Twp. 18 R. 2 WWell No. 3 SumterPalmer Company

Contractor

COMPLETED

SECTION PLAT

990 Ft. from N. Line

..... Ft. from S. Line

..... Ft. from E. Line

330 Ft. from W. Line

		0	

Location.....

Rig up.....

Drilling and Remarks:

KC. 228034 oil 5 water

RECORD

Cased.....in.,ft.

Sand.....

Gas.....

Oil.....

Total Depth 2311

PRODUCTION

1st 24 hrs. Nat.....

1st 24 hrs. after shot.....

Gas.....Cu. Ft.

Dry Hole.....

Abandoned.....

Date

7/24/30 192.....ORVAL MANNSCHRECK Scout