

Barton


KANSAS

Form 51-5M 5-37 Petrol

Section 23 Township 20 Range 11-W

Well No. 2 Alice Bryant

Company ITIO

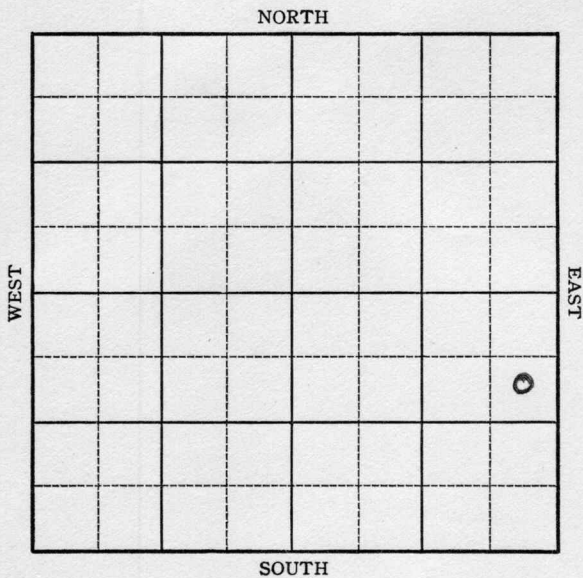


KANSAS

Barton

Sec. 23 Twp. 20 R. 11-WWell No. #2 Alice Bryant FarmI. T. I. O. Company990 Ft. from N. Line Ft. from S. Line330 Ft. from E. Line Ft. from W. Line

Elev. 1754

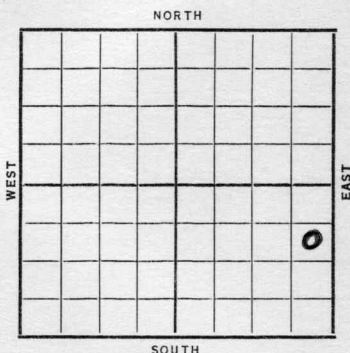

Date

REPORT

1937

12/8

Location

12/17

R U R

12/24

10" @ 199'. Drlg. 1940'.

12/31

Coring 3310'.

1938

1/5

Reworked Arb. 3308'.

T.D. 3318'.

No shows.

ABANDONED

Barton

KANSAS

Map No. _____ Sec. 23 Twp. 20 R. 11WWell No. 2 Alice Bryant

ITIO

Company

Contractor

FIRST REPORT

SE NE SE

990 Ft. from N. Line

_____ Ft. from S. Line

330 Ft. from E. Line

_____ Ft. from W. Line

SECTION PLAT

			0

Location X

Rig up _____

Drilling and Remarks:

RECORD

Cased _____ in., _____ ft.

Sand _____

Gas _____

Oil _____

Total Depth _____

PRODUCTION

1st 24 hrs. Nat. _____

1st 24 hrs. after shot _____

Gas _____ Cu. Ft.

Dry Hole _____

Abandoned _____

Date

DEC 8 - 1937

19

H. D. Hatfield

Scout

Barton

KANSAS

Map No. 46 Sec. 23 Twp. 20 R. 11W.Well No. 2 Alice BryantI. T. I. O.

Company

Contractor

ABANDONED

SE NE SE

990 Ft. from N. Line

Ft. from S. Line

330 Ft. from E. Line

Ft. from W. Line

SECTION PLAT

			0

Location _____

RECORD

Rig up _____

Cased _____ in., _____ ft.

Drilling and Remarks:

~~Sand~~ Arb 3308

Gas _____

Oil _____

Total Depth 3318

PRODUCTION

1st 24 hrs. Nat. _____

1st 24 hrs. after shot _____

Gas _____ Cu. Ft.

Dry Hole _____

Abandoned _____

Date

H. D. Hatfield

JAN 5 - 1938 19

Scout