
KANSAS Barton

FORM 51 5M 2-38 TPCO.

Section 23 Township 20 Range 11-W

Well No. #3 L. Zahorsky "A"

Company Lario & ~~Atlantic~~ I.T.I.O.

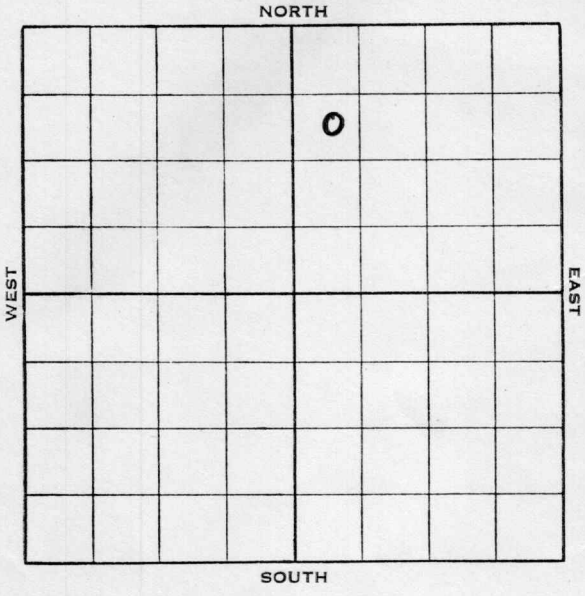

Form 252-A—5M—9-37 KANSAS Barton

Sec. 23 Twp. 20 R. 11-W

Well No. #3 L. Zahorsky "A" Farm


Lario & ~~Atlantic~~ / T.I.O. Company

990 Ft. from N. Line

_____ Ft. from S. Line

_____ Ft. from E. Line

330 ~~440~~ Ft. from W. Line

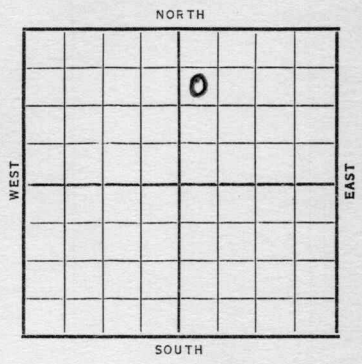

Elev. 1758

Date	REPORT
1938	
10/26	Skidding in rig.
11/4	12" - 200'. Dlg. 900'.
11/12	Drlg. 2300'.
11/18	Drlg. 3132'.
11/25	Lans. 3130'. Arb. 3270'.
	T. D. 3277'. 7" - 3271'.
11/30	7" - 3271'.
	Arb. 3270'.
	T. D. 3282'.
	Potential 1512 bbls. Nat'l.
	COMPLETED

Form 26—1M Bks.—2-29 Barton KANSAS

Map No. _____ Sec. 23 Twp. 20 R. 11W

Well No. 3- L. Zahorsky "A"

Lario & Atlantic Company
Formerly Lario & Ilio

FIRST REPORT Contractor

SW NW NE


990 Ft. from N. Line

_____ Ft. from S. Line

_____ Ft. from E. Line

440 Ft. from W. Line

SECTION PLAT

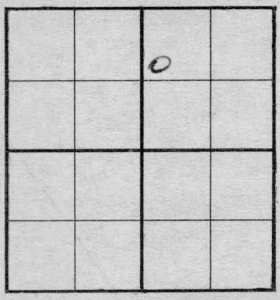

Location _____

Rig up _____

Drilling and Remarks:

Skidding in rig

RECORD

Cased _____ in., _____ ft.

Sand _____

Gas _____

Oil _____

Total Depth _____

PRODUCTION

1st 24 hrs. Nat. _____

1st 24 hrs. after shot _____

Gas _____ Cu. Ft.

Dry Hole _____

Abandoned _____

Date

OCT 26 1938 19 _____

H. D. Hatfield Scout

Form 26—1M Bks.—2-29 Barton KANSAS

Map No. 46 Sec. 23 Twp. 20 R. 11 W

Well No. 3 - L. Zahorsky "A"

Lario & (I.T. I.O) Company

Contractor

CORRECTION

990 Ft. from N. Line


Ft. from S. Line

Ft. from E. Line

330 Ft. from W. Line

CORRECTION

SECTION PLAT

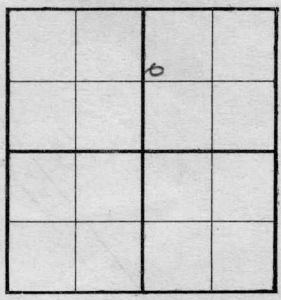

Location

Rig up

Drilling and Remarks:

1ST Reported as Lario & ATLANTIC Correct To Above

RECORD

Cased in., ft.

Sand

Gas

Oil

Total Depth

PRODUCTION

1st 24 hrs. Nat.

1st 24 hrs. after shot

Gas Cu. Ft.

Dry Hole

Abandoned

Date

NOV 2- 1938 19

H. D. Hatfield Scout

Form 26—1M Bks.—2-29 Barton KANSAS

Map No. 46 Sec. 23 Twp. 20 R. 11W

Well No. 3 L. Zahorsky "A"

Lario & I T I O Company

Contractor

COMPLETED

SW NW NE


990 Ft. from N. Line

Ft. from S. Line

Ft. from E. Line

440 Ft. from W. Line

SECTION PLAT

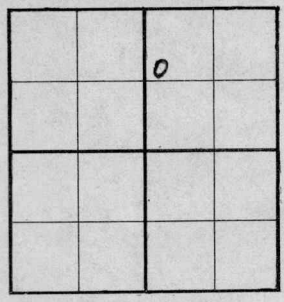

Location

Rig up

Drilling and Remarks:

POT 1512
NAT

RECORD

Cased 7 in., 3271 ft.

~~Sand~~ Arb 3270

Gas

Oil

Total Depth 3282

PRODUCTION

1st 24 hrs. Nat.

1st 24 hrs. after shot

Gas Cu. Ft.

Dry Hole

Abandoned

Date

NOV 30 1938 19

H. D. Hatfield Scout