

KANSAS


Form 51-5M-7-39-Palace

Barton

Section 23 Township 20 Range 11-W

Well No. #2 Kasselmann

Company Gulf

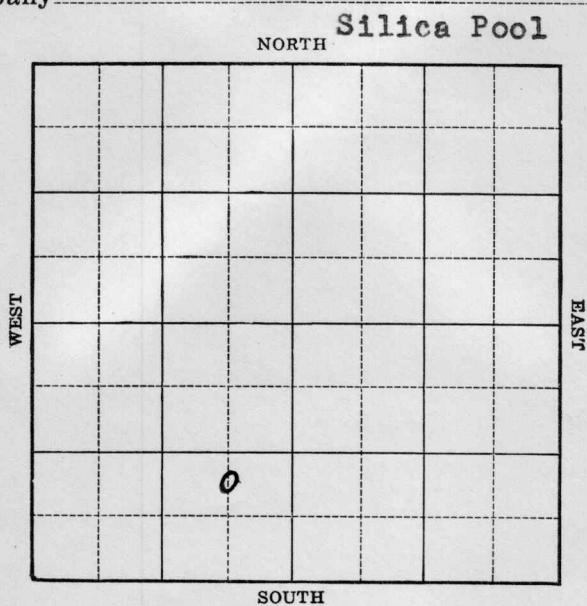

Well No. #2 Kasselmann Farm

Gulf

Company

(Silica)


_____Ft. from N. Line

990 Ft. from S. Line

660 Ft. from E. Line

Ft. from W. Line

Elev. 1757

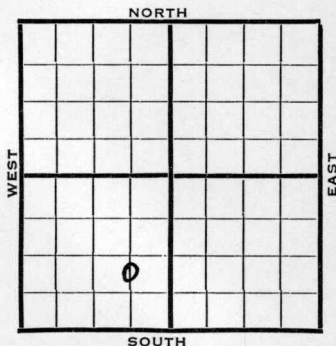[illegible]

Map No. 46 Sec. 23 Twp. 20 R. 11WWell No. 2 Kasselman
Gulf

Company

Contractor

FIRST REPORT

C N L SE SW

 Ft. from N. Line990 Ft. from S. Line660 Ft. from E. Line Ft. from W. Line

SECTION PLAT

	o		

SILICA POOL

Location Rig up

Drilling and Remarks:

Rotary

RECORD

Cased in., ft.Sand Gas Oil Total Depth

PRODUCTION

1st 24 hrs. Nat. 1st 24 hrs. after shot Gas Cu. Ft.Dry Hole Abandoned

Date

JUN 19 1940

19

S. J. LEWIS

Scout

Map No. _____ Sec. 23 Twp. 20 R. 11WWell No. 2 Kasselman

Gulf

Company

Contractor

COMPLETED

C N L SE SW

_____ Ft. from N. Line

990 Ft. from S. Line660 Ft. from E. Line

_____ Ft. from W. Line

SILICA POOL

SECTION PLAT

	0		

Location _____

Rig up _____

Drilling and Remarks:

*Art 3269 1/2**5" @ 3269 1/2**2800 acid**Sonicmeter 808**1983*

RECORD

Cased _____ in., _____ ft.

Sand _____

Gas _____

Oil _____

Total Depth 3279

PRODUCTION

1st 24 hrs. Nat. _____

1st 24 hrs. after shot _____

Gas _____ Cu. Ft.

Dry Hole _____

Abandoned _____

Date

JUL 17 1940 19S. J. LEWIS Scout