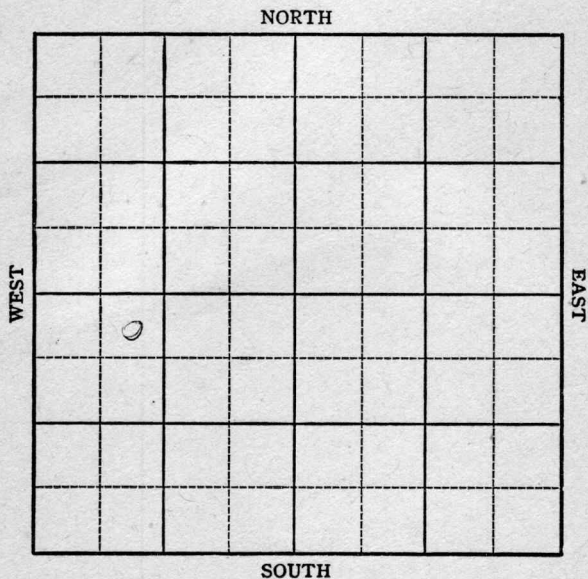


Barton

Section 23 Township 20 Range 11-WWell No. #5 KasselmanCompany Gulf

KANSAS

Barton

Sec. 23 Twp. 20 R. 11-W

Well No. #5 Kasselmann Farm
Gulf

Company


Silica Pool

330 Ft. from N. Line

Ft. from S. Line

Ft. from E. Line

990 Ft. from W. Line

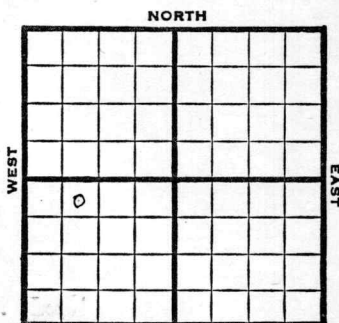

NE NW SW

Elev. 1758'

REPORT

~~1947~~

2/19 Location

2/26 8" @ 308'
Drlg 2565'

3/4 Arb 3274-76
TD 3276'
5" @ 3275'
RUST

3/11 TD 3288'
3000 Acid
Swb 2 oil PH 5 hrs

3/18 TD 3288'

3/25 " "

4/2 " "

4/9 Arb 3274
5" @ 3275'
3000 Acid
Pump 253 Pot
Grav. 42
TD 3288'

COMPLETED

Map No. 46 Sec. 23 Twp. 20 R. 11WWell No. 5 Kasselmann

Gulf

Company

FIRST REPORT

Contractor

NE NW SW

SECTION PLAT

330 Ft. from N. Line

Ft. from S. Line

Ft. from E. Line

990 Ft. from W. Line

0			

Barton County

Location X

Rig up

Drilling and Remarks:

RECORD

Cased _____ in., _____ ft.

Sand _____

Gas _____

Oil _____

Total Depth _____

PRODUCTION

1st 24 hrs. Nat. _____

1st 24 hrs. after shot _____

Gas _____ Cu. Ft.

Dry Hole _____

Abandoned _____

Date

FEB 1 9 1947 19

S. J. LEWIS

Scout

Kansas

KANSAS Silica Pool

Map No. 1546 Sec. 23 Twp. 20 R. 11WWell No. 5 Kasselmann

Gulf

Company

COMPLETE

Contractor

NE NW SW

2/1/58
SECTION PLAT330 Ft. from N. Line Ft. from S. Line Ft. from E. Line990 Ft. from W. Line

0			

Barton County

Location Rig up

Drilling and Remarks:

Cur 82745' @ 82753000 acidAug 25 8242 5/8**RECORD**Cased in., ft.Sand Gas Oil Total Depth 3288**PRODUCTION**1st 24 hrs. Nat. 1st 24 hrs. after shot Gas Cu. Ft.Dry Hole Abandoned

Date

APR 9 1947 19S. J. LEWIS Scout